

G:\Shared drives\Project Drafting\24-494\2D QDA\ Drafting\24-494\GV Starbucks\Working File\24-494 - NAE - G.V.Marketplace (Starbucks) R25_Structure.rvt

A/ TERMS AND CONDITIONS OF USE
GENERAL

THESE DRAWINGS HAVE BEEN PRODUCED FOR THE SOLE USE OF THE PROJECT CLIENT, THEIR APPOINTED AGENTS, ARCHITECTS, CONSULTANTS AND CONTRACTORS. BY THE USE OF THESE DRAWINGS AND SPECIFICATION BY THE AFOREMENTIONED FIRMS AND INDIVIDUALS, THEY ACKNOWLEDGE AND AGREE TO THE TERMS AND CONDITIONS OF USE AS NOTED BELOW.
THESE STRUCTURAL DRAWINGS AND SPECIFICATIONS HAVE BEEN PREPARED TO ILLUSTRATE THE STRUCTURAL DESIGN PHILOSOPHY AND INTENT. AS SUCH, THESE DRAWINGS PERTAIN SOLELY TO THE "BUILDING STRUCTURE" AND DO NOT ATTEMPT TO DEPICT, DETAIL OR DESIGN ELEMENTS OF THE FINISHED BUILDING DESIGN WHICH ARE THE RESPONSIBILITY OF OTHER DESIGN DISCIPLINES.

STRUCTURAL BUILDING FRAMEWORK

THESE STRUCTURAL DRAWINGS DESCRIBE THE STRUCTURAL BUILDING FRAMEWORK ONLY.

THE STRUCTURAL FRAMEWORK IS DEFINED AS THE PRIMARY GRAVITY AND LATERAL LOAD RESISTING ELEMENTS OF THE BUILDING AND INCLUDES THE FOLLOWING ITEMS WHICH MAY OR MAY NOT PERTAIN TO THIS SPECIFIC PROJECT.

- REINFORCED CONCRETE ELEMENTS WHICH COMPRISE THE PRIMARY LOAD CARRYING FRAMEWORK FOR THE BUILDING
- COMPOSITE OR NON-COMPOSITE ROOF OR FLOOR METAL DECKING
- STRUCTURAL STEEL ELEMENTS AS DEFINED BY THE AISC CODE OF STANDARD PRACTICE
- STEEL JOISTS: PRE-CAST CONCRETE SLABS, BEAMS COLUMNS OR WALL ELEMENTS

PROVISION HAS BEEN MADE WITHIN THE DESIGN OF THE STRUCTURAL BUILDING FRAMEWORK TO SUPPORT THE LOADS ARISING FROM NON-STRUCTURAL ELEMENTS. SUCH NON-STRUCTURAL ELEMENTS MAY RELY UPON THE STRUCTURAL BUILDING FRAMEWORK FOR THEIR ULTIMATE SUPPORT. HOWEVER, THE DESIGN, SUPPLY AND INSTALLATION OF SAID SUPPORT MECHANISMS ARE THE RESPONSIBILITY OF THE SPECIFIC ARCHITECTURAL OR SERVICE TRADE AND/OR OTHER ENGINEERING DISCIPLINE.

SPECIFIC ARCHITECTURAL AND SERVICE ELEMENTS MAY RELY UPON THE STRUCTURAL BUILDING FRAMEWORK FOR ULTIMATE SUPPORT YET WHOSE DESIGN AND CONTRACTUAL RESPONSIBILITY DOES NOT LIE WITH THE STRUCTURAL DESIGNER. THE DESIGNER AND/OR PROVIDERS OF THE FOLLOWING ELEMENTS, ARE WHOLLY RESPONSIBLE FOR DELIVERING THEIR LOADS TO THE STRUCTURE AS DEFINED BY THESE DRAWINGS.

- EXTERIOR BUILDING CLADDING SYSTEM, INCLUDING WIND RESISTING LIGHTWEIGHT METAL STUD SYSTEMS AND CONCRETE MASONRY WALLS
- NON-LOAD BEARING PARTITIONS
- ANY AND ALL SLABS, TOPPING AND FINISHES (WHETHER OR NOT THEY CONTAIN REINFORCING MATERIALS) NOT ATTACHED TO THE STRUCTURAL BUILDING FRAMEWORK NOR DEFINED ON THE STRUCTURAL DRAWINGS
- BUILDING SERVICES AND EQUIPMENT INCLUDING ANY AND ALL ELEMENTS AND THEIR SUPPORTING ACCESSORIES
- ELEVATING AND CONVEYING SYSTEMS
- ALL EMBEDDED OR SURFACE APPLIED CONNECTION MEANS NOT INTENDED TO SUPPORT A PORTION OF THE STRUCTURAL BUILDING FRAMEWORK

WHERE APPROPRIATE, THE DESIGN AND INSTALLATION OF SUCH ELEMENTS SHALL BE PROVIDED BY A PROFESSIONAL ENGINEER, LICENSED WITHIN THE RELEVANT JURISDICTION. AS THE STRUCTURAL DESIGNER, QUINN DRESSEL ASSOCIATES IS NOT RESPONSIBLE FOR THE DESIGN OF SUCH ELEMENTS, NOR THE METHOD OR MEANS OF CONNECTING SUCH ELEMENTS TO THE BUILDING STRUCTURE.

NOTWITHSTANDING THE ABOVE, QUINN DRESSEL ASSOCIATES SHALL HAVE SOLE DISCRETION TO REJECT ANY CONNECTION METHOD OR EMBEDDED ITEM WHICH WE JUDGE TO BE DETRIMENTAL TO THE PERFORMANCE OF THE STRUCTURAL BUILDING FRAMEWORK.

SHOP DRAWINGS

IT IS UNDERSTOOD AND ACKNOWLEDGED BY ALL THAT THE CO-ORDINATION AND PREPARATION OF THE SHOP DRAWINGS IS THE RESPONSIBILITY OF THE GENERAL CONTRACTOR, CONSTRUCTION MANAGER OR PROJECT MANAGER.

QUINN DRESSEL ASSOCIATES WILL RECEIVE AND REVIEW, SHOP DRAWINGS PREPARED BY THE STRUCTURAL TRADES. SUCH REVIEW, IS FOR THE SOLE PURPOSE OF ASCERTAINING CONFORMANCE WITH THE GENERAL DESIGN CONCEPT, CRITERIA AND INTENT. TYPICALLY THIS WILL INCLUDE THE FOLLOWING:

- TEMPORARY EXCAVATION SHORING PLANS AND DETAILS
- CONCRETE FALSEWORK DRAWINGS
- REINFORCING STEEL SHOP DRAWINGS
- POST-TENSION PLANS AND DETAILS
- WOOD FRAME SHOP DRAWINGS
- STRUCTURAL STEEL SHOP DRAWINGS
- METAL DECK SHOP DRAWINGS
- STEEL JOIST SHOP DRAWINGS
- STRUCTURAL PRE-CAST SHOP DRAWINGS

WHERE SO DIRECTED BY THE CONTRACT DOCUMENTS, THE ABOVE SUBMISSION MAY REQUIRE THE SEAL AND SIGNATURE OF A PROFESSIONAL ENGINEER, SO REGISTERED IN THE GOVERNING JURISDICTION. IN SUCH INSTANCES, THE SOLE RESPONSIBILITY FOR THE DESIGN OF SUCH ELEMENTS LIES WITH THAT DESIGNER AND IS OUTSIDE OF THE SCOPE OF SERVICES PROVIDED BY QUINN DRESSEL ASSOCIATES.

QUINN DRESSEL ASSOCIATES WILL ALSO RECEIVE AND PROVIDE A LIMITED REVIEW OF SHOP DRAWINGS PREPARED BY TRADES OTHER THAN STRUCTURAL. SUCH REVIEW IS UNDERTAKEN SOLELY TO ASCERTAIN THE EFFECTS OF THE WORK OF OTHER TRADES UPON THE STRUCTURAL BUILDING FRAMEWORK, AND IS LIMITED TO A REVIEW OF THE LOADS AND MANNER IN WHICH THE LOADS ARE DELIVERED TO THE STRUCTURAL BUILDING FRAMEWORK.

TYPICALLY, DRAWINGS PREPARED BY TRADES OTHER THAN STRUCTURAL WOULD INCLUDE:

- EXTERIOR BUILDING CLADDING SYSTEM, INDICATING LOADS AND ATTACHMENT METHODOLOGY
- SLEEVEING DRAWINGS PREPARED BY THE MECHANICAL OR ELECTRICAL TRADES
- CORE REQUESTS BY THE MECHANICAL OR ELECTRICAL TRADES
- EQUIPMENT AND/OR PIPING LOADS AND ATTACHMENT METHODOLOGY
- WINDOW WASHING EQUIPMENT AND ANCHOR ATTACHMENTS

DRAWINGS RECEIVED WHICH DO NOT CONTAIN ADEQUATE LOADING INFORMATION WILL BE RETURNED AS "REJECTED". DRAWINGS WHICH ARE OF NO RELEVANCE TO A STRUCTURAL REVIEW WILL BE RETURNED AS "NO STRUCTURAL RELEVANCE - NOT REVIEWED".

RESPONSIBILITY FOR THE ADEQUACY AND SAFE OPERATION OF SUCH EQUIPMENT, ITS APPENDAGES, ANCHORAGES AND VARIOUS SUPPORTS MECHANISMS WHETHER APPLIED TO OR EMBEDDED WITHIN THE STRUCTURAL BUILDING FRAMEWORK IS THE SOLE RESPONSIBILITY OF ITS DESIGNER OR RELATED CONTRACTOR, AND IS NOT THE RESPONSIBILITY OF QUINN DRESSEL ASSOCIATES.

B/ GENERAL

1. THE FOLLOWING GENERAL NOTES AND TYPICAL DETAILS SHOWN ON THE DRAWINGS ARE APPLICABLE TO ALL STRUCTURAL CONDITIONS NOT SPECIFICALLY DETAILED ON THE STRUCTURAL DRAWINGS.
2. THE STRUCTURAL DRAWINGS SHALL BE READ WITH THE SPECIFICATIONS AND OTHER CONTRACT DOCUMENTS.
3. REFER TO THE ARCHITECTURAL DRAWINGS FOR FIRE SEPARATION REQUIREMENTS.
4. ONLY DIMENSIONS RELEVANT TO STRUCTURAL ELEMENTS ARE SHOWN ON THE STRUCTURAL DRAWINGS. FOR OTHER DIMENSIONS, AND LOCATIONS, SIZES OF SLEEVES OR FORMED OPENINGS NO SHOWN, REFER TO OTHER CONTRACT DRAWINGS AND DOCUMENTS. OBTAIN THE ARCHITECT'S PRIOR APPROVAL BEFORE INSTALLING SUCH OPENINGS, SLEEVES ETC.
5. SEE OTHER CONTRACT DRAWINGS FOR LOCATIONS AND DIMENSIONS OF PITS, BASES, SUMPS, TRENCHES, DEPRESSIONS, GROOVES, AND CHAMFERS NOT SHOWN ON STRUCTURAL DRAWINGS.
6. THE DESIGN LIVE LOAD SHOWN ON THE DRAWINGS SHALL NOT BE EXCEEDED DURING CONSTRUCTION. THE CONTRACTOR SHALL MAKE ADEQUATE PROVISIONS FOR CONSTRUCTION LOADS AND FOR ADEQUATE TEMPORARY BRACING TO KEEP ALL STRUCTURAL AND NON-STRUCTURAL ELEMENTS PLUMB AND IN TRUE ALIGNMENT AT ALL PHASES OF CONSTRUCTION.

C/ MATERIAL

CONCRETE:

ELEMENT	EXPOSURE CLASS	COMPRESSIVE STRENGTH f_c (MPa)	AIR CONTENT CATEGORY	CHLORIDE ION PENETRABILITY (COULOMBS)	COMMENTS
SLAB-ON-GRADE:					
BUILDING INTERIOR	N	25	-		-
EXTERIOR	C-2	32	1		W/C $\leq$ 0.45
REINFORCED CONCRETE WALL, PIER, CURB, BEAM:					
INTERIOR	N	30	-		-
EXTERIOR	F-2	35	2		W/C $\leq$ 0.55

COMPRESSIVE STRENGTH f_c IS THE ULTIMATE COMPRESSIVE STRENGTH AT: 28 DAYS FOR COMPRESSIVE STRENGTHS < 40 MPA 56 DAYS FOR COMPRESSIVE STRENGTHS > 40 MPA & < 55 MPA 90 DAYS FOR COMPRESSIVE STRENGTHS > 55 MPA

2. REINFORCING STEEL

TYPE	f_y - MIN. YIELD STRENGTH (MPa)	REMARKS
WELDED WIRE FABRIC	400	
DEFORMED REINFORCING STEEL	400	

ALL REINFORCING STEEL TO CONFORM TO CSA G30

DESIGNATION	TYPE	YIELD STRENGTH (MPa)	MIN. TENSILE STRENGTH (MPa)
G40.21	350W	350	450

HSS TO BE CLASS C UNO

D/ STANDARDS & DESIGN CRITERIA
GENERAL

THIS BUILDING HAS BEEN DESIGNED IN ACCORDANCE WITH THE FOLLOWING CODES AND STANDARDS:

OBC REG 332/12
CAN3 A23.1
CAN3 A23.3-19
CAN/CSA S16-19
CSA 086-19

IMPORTANCE CATEGORY

THIS BUILDING HAS BEEN DESIGNED FOR AN IMPORTANCE CATEGORY OF NORMAL.

DEAD LOADS

THE BUILDING HAS BEEN DESIGN TO RESIST THE FOLLOWING DEAD LOADS. SPECIFIC DESIGN VALUES ARE REFERENCED ON INDIVIDUAL FRAMING PLANS.

- BUILDING SELF-WEIGHT
- WEIGHT OF ALL MATERIAL OF CONSTRUCTION INCORPORATED INTO THE BUILDING AND PERMANENTLY SUPPORTED THEREON.
- WEIGHT OF PARTITIONS, WHERE APPLICABLE.
- VERTICAL GRAVITY LOADS DUE TO SOIL, PLANTING MATERIAL AND TREES.

LIVE LOADS

THE BUILDING HAS BEEN DESIGNED TO RESIST LIVE LOADS DUE TO USE AND OCCUPANCY. SPECIFIC DESIGN VALUES ARE REFERENCED ON INDIVIDUAL FRAMING PLANS. LIVE LOAD REDUCTIONS AS PERMITTED UNDER THE APPLICABLE GOVERNING CODE HAVE BEEN INCORPORATED INTO THE ELEMENT DESIGNS WHERE APPROPRIATE.

SNOW & RAIN

THE BUILDING'S ROOFS HAVE BEEN DESIGNED TO RESIST LOADS DUE TO SNOW AND RAIN AS DEFINED BY THE APPLICABLE CODE. THE FOLLOWING FACTORS ARE UNIQUE TO THIS BUILDING.

$S_s = 1.8 \text{ KN/m}^2$
 $S_r = 0.4 \text{ KN/m}^2$
 $I_s = 1.0(\text{U.S.}); 0.9(\text{SLS})$

THE TEMPORARY RETENTION OF RAIN WATER THROUGH THE USE OF CONTROL FLOW DRAINAGE MECHANISMS HAS BEEN INCORPORATED INTO THE BUILDING'S DESIGN TO A MAXIMUM DEPTH OF 100mm.

WIND

THE BUILDING HAS BEEN DESIGNED TO RESIST WIND FORCES AS CALCULATED THROUGH A "STATIC PROCEDURE" AS PROVIDED FOR UNDER THE APPLICABLE GOVERNING CODE.

THE BUILDING HAS BEEN DESIGNED TO RESIST WIND FORCES AS CALCULATED IN ACCORDANCE WITH THE FOLLOWING FORMULA:

$$P = I_w Q C_e C_{pe} C_t C_g C_p$$

Q (1 IN 50 YEAR REFERENCE VELOCITY PRESSURE) = 0.43 KPA
 C_e (BASED UPON OPEN ROUGH TERRAIN) = 0.9
 C_t (TOPOGRAPHIC FACTOR) = 1.0
 C_g (GUST EFFECT FACTOR) SEE FIGURE 4.1.7.6 A & B
 C_p (EXTERNAL PRESSURE COEFFICIENT) SEE FIGURE 4.1.7.6 A & B
 I_w (IMPORTANCE FACTOR) = 1.0(U.S.); 0.75(SLS)

EARTHQUAKE

SITE PROPERTIES:

$PGA = 0.207$
 $S_s(0.2) = 0.321$
 $S_w(0.5) = 0.157$
 $S_s(1.0) = 0.072$
 $S_w(2.0) = 0.032$
 $S_s(5.0) = 0.0075$
 $S_s(10.0) = 0.030$
ASSUME SITE CLASS "C"
 $F_a = 1.0$
 $F_v = 1.0$

FORCE MODIFICATION FACTOR

$R_d = 1.5, R_o = 1.3$ (TIMBER STRUCTURE-SHEAR WALL AND STEEL MOMENT FRAME)
IMPORTANCE FACTOR $I_e = 1.0$
 $I_e F_a S_s(0.2) = 1.0 * 1.0 * 0.321 = 0.321$
FUNDAMENTAL LATERAL PERIOD (EQUVALENT STATIC METHOD)
 $T = 0.167$ (BOTH DIRECTIONS)

E/ LATERAL LOAD RESISTING SYSTEM

LATERAL WIND AND EARTHQUAKE FORCES ARE RESISTED IN BOTH DIRECTIONS WITH TIMBER SHEAR WALLS AND STEEL MOMENT FRAME DESIGNED IN ACCORDANCE WITH CSA S16-19 CLAUSE 27, CSA 086 AND 08C2012.

G/ SLAB ON GRADE

1. PLACE SLAB ON GRADE ON MATERIAL CAPABLE OF SUSTAINING 24 KN/m² WITHOUT SETTLEMENT RELATIVE TO THE BUILDING FOUNDATIONS.
2. FOR THICKNESS OF SLAB ON GRADE SEE FOUNDATION PLAN. MAINTAIN SLAB THICKNESS AT ALL DEPRESSIONS. SEE ARCHITECTURAL DRAWINGS FOR LOCATION AND EXTENT OF FINISHES AND DEPRESSIONS.
3. UNLESS NOTED ON PLAN OTHERWISE, PROVIDE A MINIMUM OF WELDED WIRE FABRIC REINFORCING 152x152 - MW 18.7MM 18.7.

H/ CONCRETE PAD

1. HOUSEKEEPING CONCRETE PIS IS 100mm HIGH, REINFORCED WITH 10@500HEF AND 10@2000 VERTICAL DOWELS ($f_c \geq 30 \text{ MPa}$). TYPICAL, UNLESS NOTED OTHERWISE. SEE ARCHITECTURAL AND MECHANICAL DRAWINGS FOR SIZE AND LOCATION.

I/ CONCRETE AND REINFORCING

1. CONCRETE COVER TO REINFORCING: 75mm
2. ALL CONCRETE POURED AGAINST EARTH
3. ALL CONCRETE POURED IN FORMS, BUT EXPOSED TO EARTH OR WEATHER: BARS LARGER THAN 15M IN WALLS AND SLABS OR MAIN BARS IN BEAMS AND COLUMNS 50mm BARS 15M AND SMALLER 40mm
- a. CONCRETE NOT EXPOSED TO EARTH OR WEATHER: SLABS AND WALLS 25mm SHEAR WALLS 50mm BEAMS AND COLUMNS TO STIRRUPS OR TIES 40mm
- a. ALL CONCRETE SLABS EXPOSED TO DE-ICING SALTS TOP BARS 40mm BOTTOM BARS 30mm
1. MINIMUM CLEAR DISTANCE BETWEEN PARALLEL BARS SHALL BE THE GREATEST OF THE FOLLOWING: 1.4 TIMES BAR DIAMETER
2. 1.4 TIMES MAXIMUM SIZE OF AGGREGATE
3. 30mm MINIMUM LAPS OF CONTINUOUS DEFORMED BARS SHALL BE 24 Ø OR 450mm WHICHEVER IS GREATER. LAPS OF WELDED WIRE FABRIC SHALL BE 150mm AT ENDS AND EDGES. INCREASE LAPS BY 20% FOR EPOXY COATED BARS.
5. ALL DOWELS SHALL HAVE A MINIMUM EMBEDMENT OF 24 Ø OR 450mm MINIMUM, EXCEPT THAT DOWELS TO SLAB SHALL HAVE A MINIMUM EMBEDMENT OF 600mm. INCREASE LAP LENGTHS BY 20% FOR EPOXY COATED BARS.

TIMBER:

1. TIMBER DESIGN SHALL COMPLY WITH CSA 086 & CSA 0141 AT LATEST VERSION.
2. ALL JOISTS, RAFTERS, SHORING, BRACING, BLOCKING, STUDS OR STUD WALL SHALL BE NO. 1 OR NO. 2 SPF (SPRUCE-PINE-FIR) OR BETTER UNLESS NOTED OTHERWISE. ALL MATERIALS SHALL CONFORM TO CAN3-086 AND CSA 0141, INCLUDING ALL APPENDICES, AND SHALL BE SUPPLIED AS DRY LUMBER (MOISTURE CONTENT 19% MAX). GRADING SHALL CONFORM TO THE RULE OF THE NATIONAL LUMBER GRADES AUTHORITY (NLGA).
3. FLOOR JOISTS, STUDS, AND ALL OTHER STRUCTURAL MEMBERS OTHER THAN SPECIFIED, SHALL COMPLY WITH MANUFACTURER'S SPEC.
4. PROVIDE ALL ROUGH HARDWARE AND FASTENINGS INCLUDING BOLTS, NAILS, SCREWS, WASHERS, STRAPS, ANCHORS AS REQUIRED FOR THE WORK TO BE DONE. MATERIAL SHALL CONFORM TO THE FOLLOWING STANDARDS:
NAILS AND STAPLES: CSA B111;
SCREWS: CSA B35;
WASHERS: CSA B19.1;
BOLTS AND LAG BOLTS: ASTM A307
5. WHERE PLYWOOD IS REQUIRED, IT SHALL CONFORM TO CSA 0121-17.
6. ALL LVL BEAMS ARE MICROLAM 2.1/E LVL TYPE OR BETTER.
7. CONNECTIONS FOR STUDS, RAFTERS, AND JOISTS SHALL COMPLY WITH REQUIREMENTS IN PART 9 OBC, AND TABLE 9.23.3.4. UNLESS NOTED OTHERWISE; MIN. NAIL DIAMETER IS 4.88mm UNLESS NOTED OTHERWISE.
8. ALL FLUSH JOISTS SHALL BE SUPPORTED WITH STEEL JOIST HANGERS MANUFACTURED BY SIMPSON STRONG TIE OR APPROVED EQUAL.
9. COLUMNS SHALL BE SECURELY FASTENED TO THE BEAM TO PREVENT LATERAL MOVEMENT.
10. PROVIDE SOLID BLOCKING THE FULL WIDTH OF THE SUPPORTED MEMBER UNDER ALL CONCENTRATED LOADS.
11. NO HOLES ARE TO BE CUT OR DRILLED IN JOISTS EXCEPT AS PERMITTED IN THE BUILDING CODE, OR BY THE WOOD MANUFACTURER. LATEST APPROVED DRAWINGS SUPERSEDE ALL PREVIOUSLY SUBMITTED AND STAMPED DRAWINGS.
12. ALL EXTERIOR EXPOSED WOOD SHALL BE PRESSURE TREATED PINE.
13. ALL TEMPORARY BRACING SHALL BE SUPPLIED AS NECESSARY TO FACILITATE STABLE INSTALLATION.
14. PROVIDE 3 - 2x8 NO. 1 OR NO. 2 SPF FOR LINTELS WITH SPAN LESS THAN 5'-0".
15. WOOD DECK IS 3/4" THICKNESS D.FIR DOUBLE TONGUE AND GROOVE PLANK DECKING UNLESS NOTED OTHERWISE.

1 2024-09-25
2 2024-10-28

ISSUED FOR PERMIT
ISSUED FOR CONSTRUCTION



Quinn Dressel
ASSOCIATES
CONSULTING STRUCTURAL ENGINEERS





4687 Queen Street Suite 2,
Niagara Falls, ON, L2E 2L9
T | 905-357-4441
F | 905-357-9203
W | www.raimondoaarchitects.com
E | mail@raimondoaarchitects.com

CLIENT NAME

Niagara Adventure Excursion Inc.

PROJECT NAME

Grand View Marketplace Starbucks

PROJECT ADDRESS

5920 Niagara River Pkwy, Niagara Falls, ON

SHEET NAME

GENERAL NOTES

DRAWN BY:

JC

DATE:

2025-01-23 10:50:31 AM

SCALE:

As indicated

PROJECT NO.:

24-094

CHECKED:

RY

DRAWINGS ARE NOT VALID FOR CONSTRUCTION UNTIL SEALED AND SIGNED BY THE ARCHITECT.
DO NOT SCALE DRAWINGS. REPORT ALL DISCREPANCIES TO THE ARCHITECT BEFORE PROCEEDING. ALL DRAWINGS AND DESIGNS REMAIN THE PROPERTY OF THE ARCHITECT, AND ARE PROTECTED UNDER COPYRIGHT.
THESE DESIGN DOCUMENTS ARE PREPARED SOLELY FOR THE USE BY THE PARTY WITH WHOM THE DESIGN PROFESSIONAL HAS ENTERED INTO A CONTRACT AND THERE ARE NO REPRESENTATIONS OF ANY KIND MADE BY THE DESIGN PROFESSIONAL TO ANY PARTY WITH WHOM THE DESIGN PROFESSIONAL HAS NOT ENTERED INTO A CONTRACT.

G:\Shared drives\Project Drafting\24-494\GV Starbucks\Working File\24-494 - NAE - GV Marketplace (Starbucks) R25_Structure.rvt

TD101	ELEVATION OF ADJACENT FOOTING AND EXCAVATION	TD106	TYPICAL SUMP PIT DETAILS	TD107	SAWCUTS IN SLAB ON GRADE	TD201	SLAB, WALL AND FOOTING DETAILS	TD204	COLUMN TIES	TD217	CONSTRUCTION JOINTS
TD105	PIPE CROSSING BELOW FOOTING	TD108	SLAB DETAIL AT MASONRY PARTITION	TD521	BASE PLATE DETAILS	TD531	REINFORCING BAR TENSION DEVELOPMENT AND SPLICES	TD801	ABBREVIATIONS		
TD221	CONSTRUCTION JOINT BETWEEN NEW & EXISTING WALL	TD302	SLEEVES THROUGH WALLS, SLABS AND BEAMS								
TD222	CURBS AND PARAPETS										
TD229	MINIMUM WALL REINFORCING	TD518	COLUMN COMPRESSION LAP SPLICES	TD519	SCHEDULE FOR MINIMUM FILLET WELD SIZE FOR BUILT-UP COLUMNS & BEAMS	TD610	PARTITION WALL BRACING TO STEEL BEAM				

1 2024-09-25
2 2024-10-28



4687 Queen Street Suite 2,
Niagara Falls, ON, L2E 2L9
T | 905-357-4441
F | 905-357-9203
W | www.raidmondarchitects.com
E | mail@raidmondarchitects.com

CLIENT NAME

Niagara Adventure Excursion Inc.

PROJECT NAME

Grand View Marketplace
Starbucks

PROJECT ADDRESS

5920 Niagara River Pkwy, Niagara Falls, ON

SHEET NAME

TYPICAL DETAILS

DRAWN BY: JC
DATE: 2025-01-23 10:50:38 AM
SCALE: 1 : 100
PROJECT NO.: 24-094
CHECKED: RY


DRAWINGS ARE NOT VALID FOR CONSTRUCTION UNTIL SEALED AND SIGNED BY THE ARCHITECT.
DO NOT SCALE DRAWINGS. REPORT ALL DISCREPANCIES TO THE ARCHITECT BEFORE PROCEEDING. ALL DRAWINGS AND DESIGNS REMAIN THE PROPERTY OF THE ARCHITECT, AND ARE PROTECTED UNDER COPYRIGHT.
THESE DESIGN DOCUMENTS ARE PREPARED SOLELY FOR THE USE BY THE PARTY WITH WHOM THE DESIGN PROFESSIONAL HAS ENTERED INTO A CONTRACT AND THERE ARE NO REPRESENTATIONS OF ANY KIND MADE BY THE DESIGN PROFESSIONAL TO ANY PARTY WITH WHOM THE DESIGN PROFESSIONAL HAS NOT ENTERED INTO A CONTRACT.

SHEET #


S102

REV. #


G:\Shared drives\Project Drafting\24-094 QDA Drafting\24-094 GV Starbucks\Working File\24-094 - NAE - G.V. Marketplace (Starbucks) R25_Structure.rvt

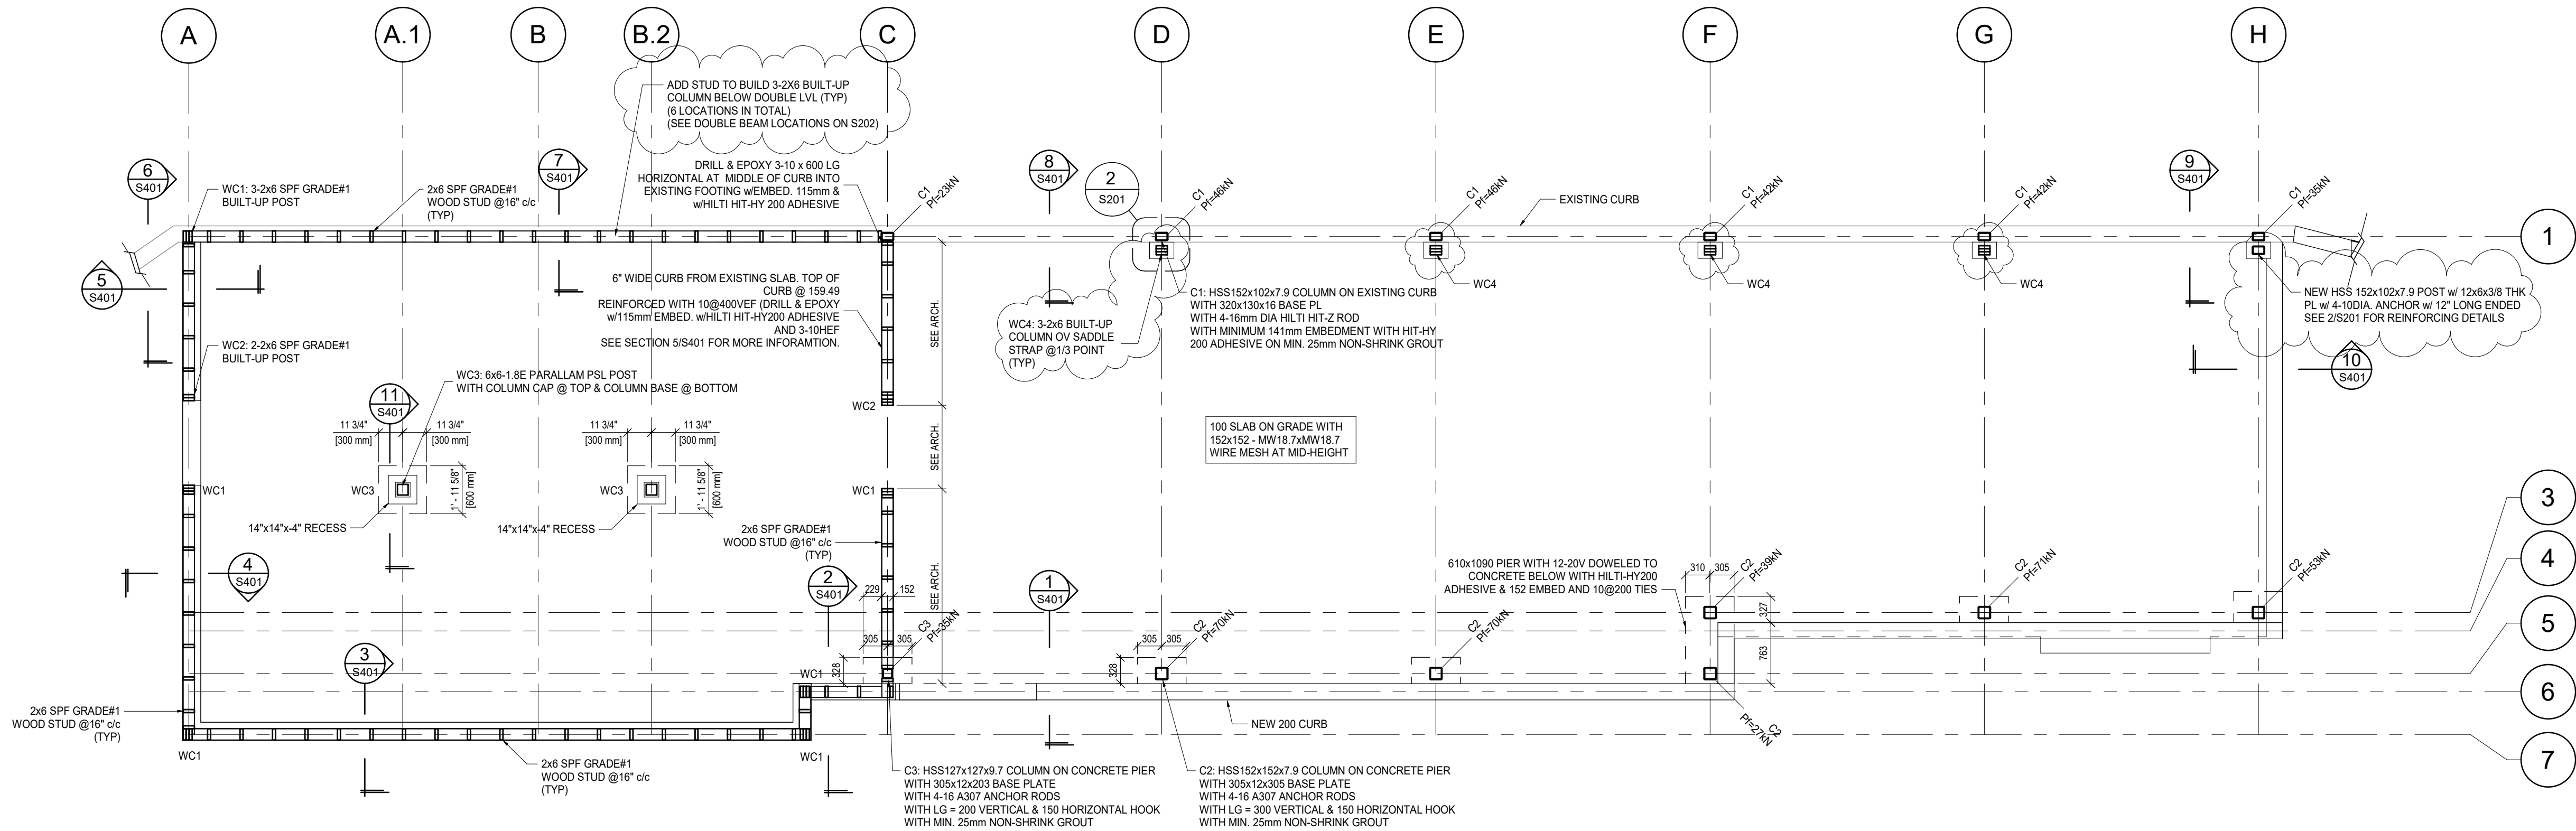

1 1ST FLOOR LEVEL
1 : 50

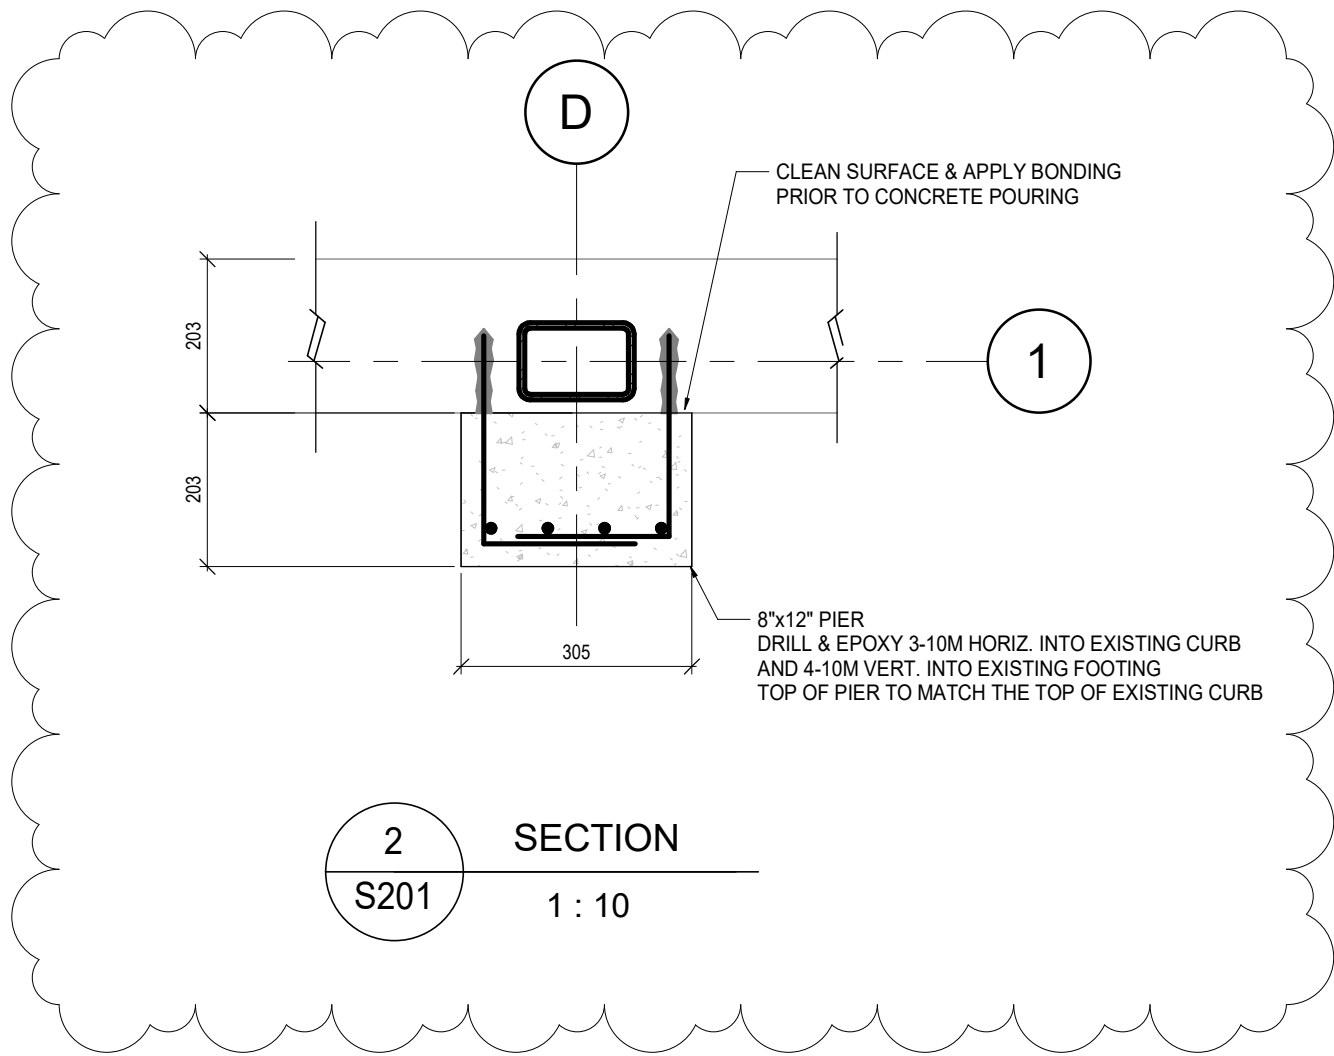

2 SECTION
1 : 10

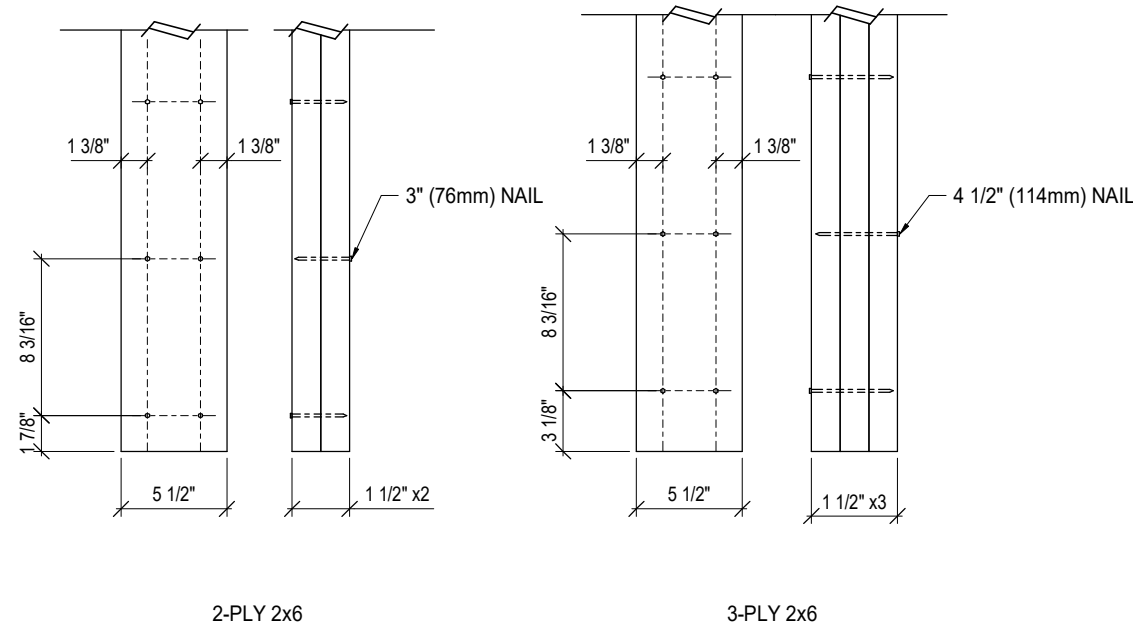

BUILT-UP COLUMN DETAILS

NOTES:
X-RAY OR REBAR SCAN EXISTING CONCRETE SLABS, BEAMS AND COLUMNS TO LOCATE EXISTING REINFORCING STEEL, STIRRUPS, TIES, AND CONDUITS. DO NOT DRILL THROUGH ANY EXISTING REINFORCEMENT AND DO NOT CUT ANY EXISTING CONDUITS.

ALL EXISTING INFORMATION SHOWN ON DRAWINGS IS TRANSFERRED FROM EXISTING BASE BUILDING DRAWINGS. CONTRACTOR SHALL BE RESPONSIBLE TO SITE VERIFY THE ACCURACY OF THESE DOCUMENTS WITH AS-BUILT CONDITIONS. ALL DETERMINATION OF EXISTING CONDITIONS MUST BE MADE PRIOR TO ANY STRUCTURAL DEMOLITION.

1 2024-09-25 ISSUED FOR PERMIT
2 2024-10-28 ISSUED FOR CONSTRUCTION
3 2025-01-23 ISSUED FOR COORDINATION



4687 Queen Street Suite 2,
Niagara Falls, ON, L2E 2L9
T | 905-357-4441
F | 905-357-9203
W | www.raidmondarchitects.com
E | mail@raidmondarchitects.com

CLIENT NAME

Niagara Adventure Excursion Inc.

PROJECT NAME

Grand View Marketplace
Starbucks

PROJECT ADDRESS

5920 Niagara River Pkwy, Niagara Falls, ON

SHEET NAME

GROUND FLOOR
FRAMING PLAN

DRAWN BY: JC
DATE: 2025-01-23 10:50:41 AM
SCALE: As indicated
PROJECT NO.: 24-094
CHECKED: RY

DRAWINGS ARE NOT VALID FOR CONSTRUCTION UNTIL SEALED AND SIGNED BY THE ARCHITECT.
DO NOT SCALE DRAWINGS. REPORT ALL DISCREPANCIES TO THE ARCHITECT BEFORE PROCEEDING. ALL DRAWINGS AND DESIGNS REMAIN THE PROPERTY OF THE ARCHITECT, AND ARE PROTECTED UNDER COPYRIGHT.


THESE DESIGN DOCUMENTS ARE PREPARED SOLELY FOR THE USE BY THE PARTY WITH WHOM THE DESIGN PROFESSIONAL HAS ENTERED INTO A CONTRACT AND THERE ARE NO REPRESENTATIONS OF ANY KIND MADE BY THE DESIGN PROFESSIONAL TO ANY PARTY WITH WHOM THE DESIGN PROFESSIONAL HAS NOT ENTERED INTO A CONTRACT.

SHEET #


S201

REV. #

G:\Shared drives\Project Drafting\24-094 G.V Starbucks\Working File\24-094 - NAE - G.V.Marketplace (Starbucks) R25_Structure.rvt

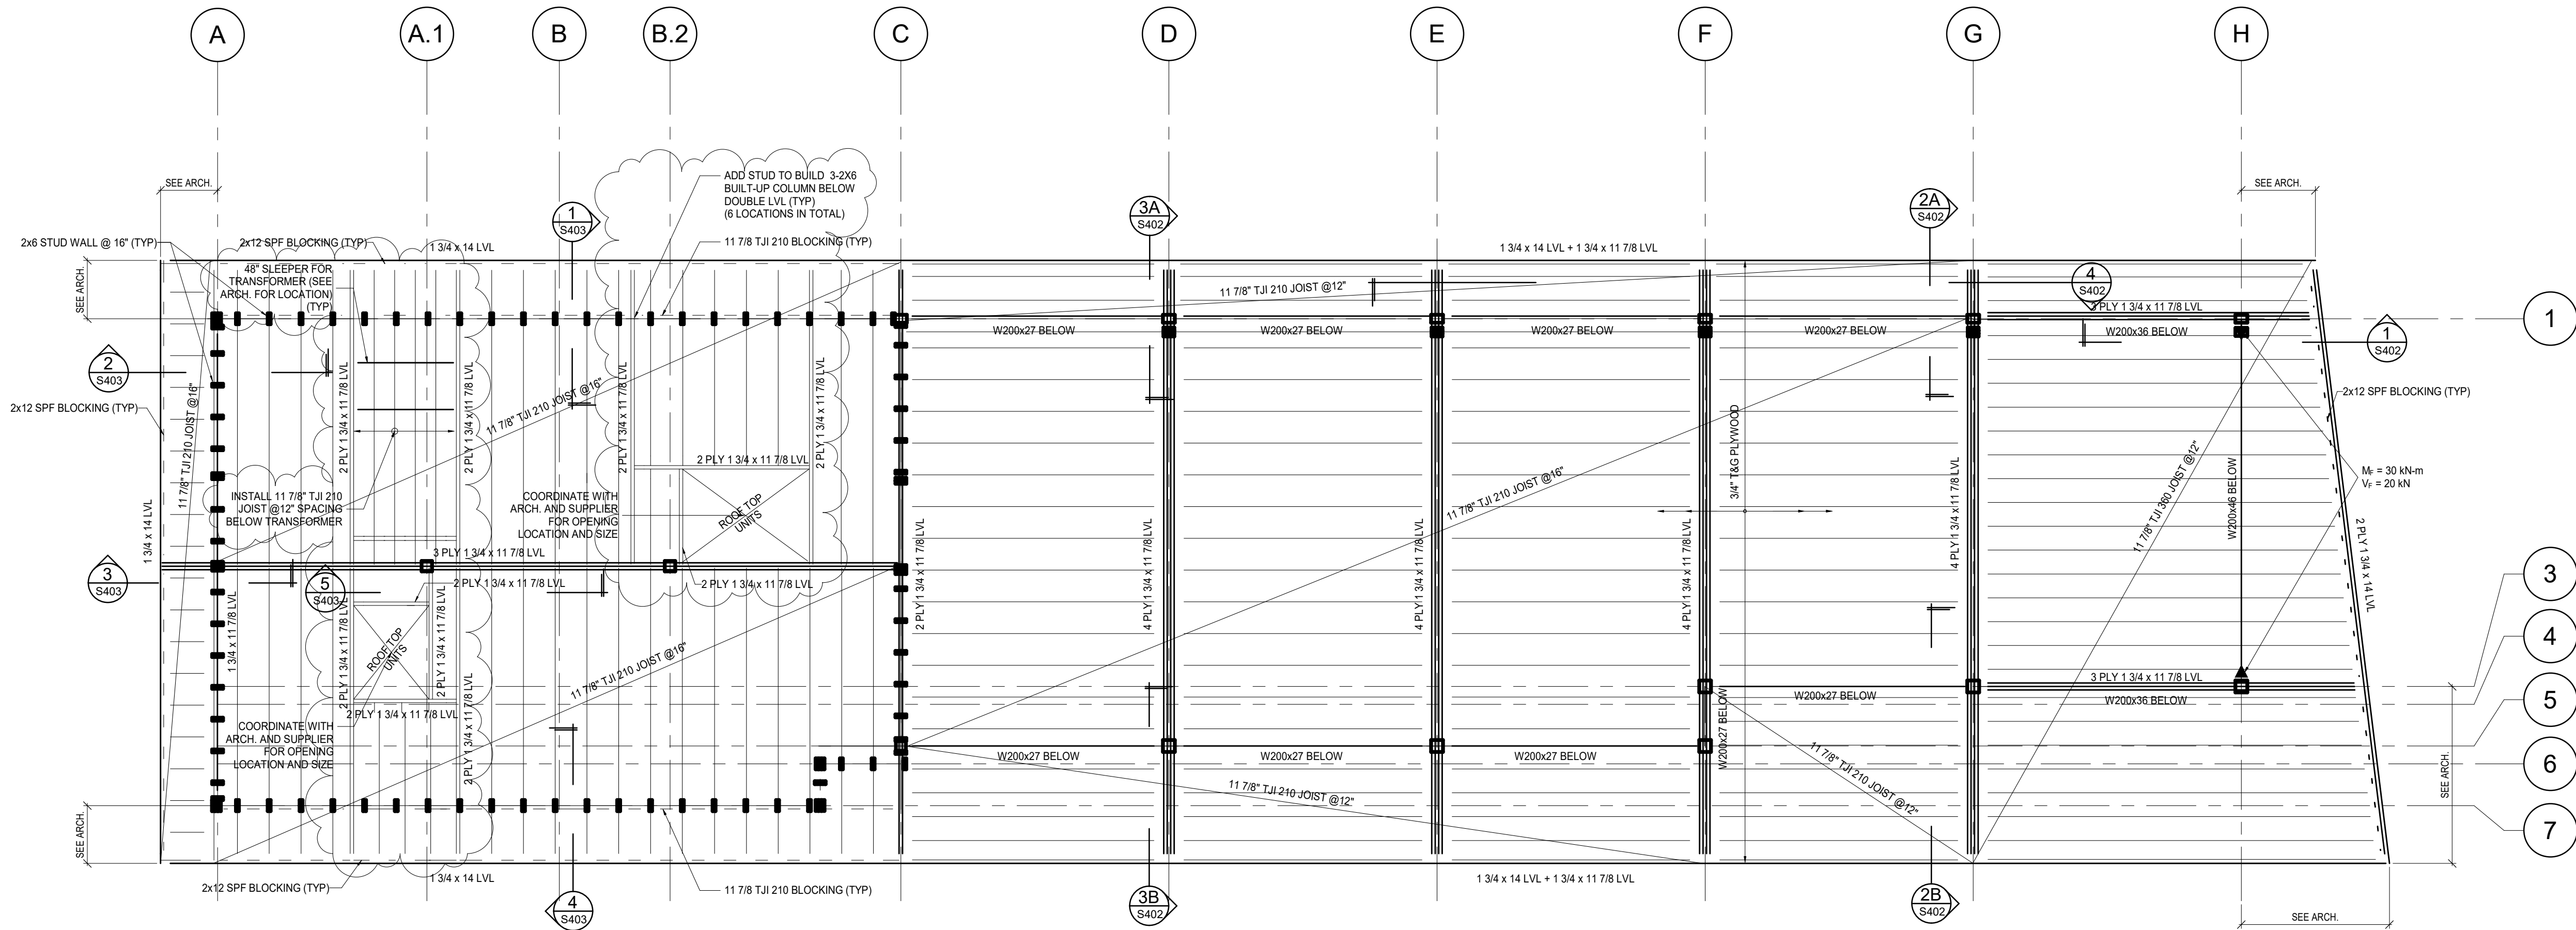

1 ROOF FRAMING
S202 1 : 50

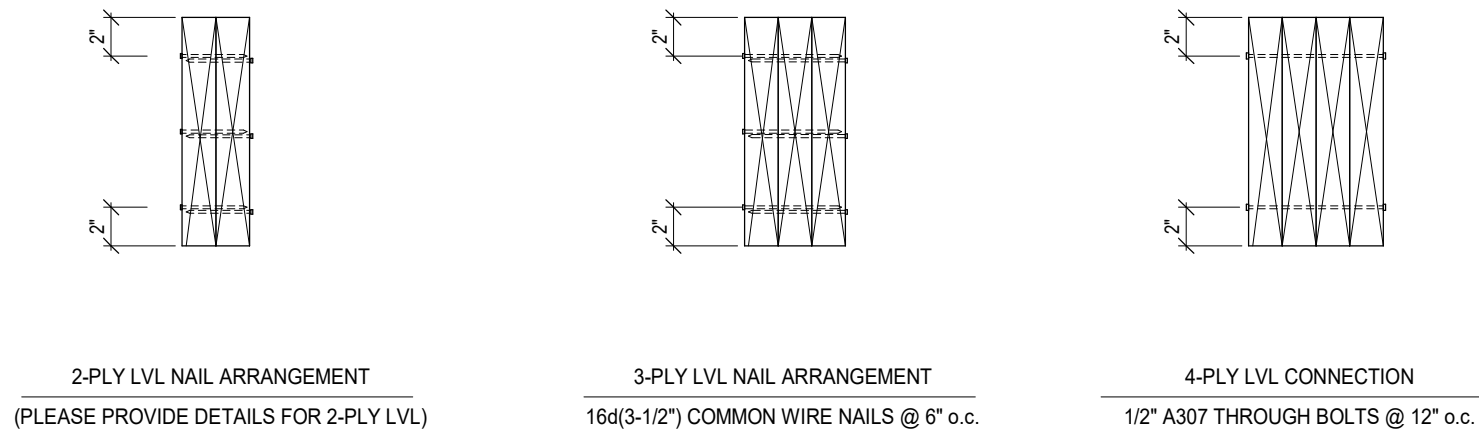

- NOTES:
- TOP OF TJI JOIST IS AT 163.35m UNLESS NOTED OTHERWISE.
 - ROOF DESIGN LOADS:
SUPERIMPOSED DEAD:
SELF WEIGHT:
ROOFING: 0.1KPA (2LBS/FT²)
CEILING E&M : 0.3KPA (6.5LBS/FT²)
LIVE LOAD: 0.5KPA (10LBS/FT²)
SNOW LOAD: 1.9KPA (40LBS/FT²)
 - ROOF TOP UNITS SEE PLAN:
A. TRANSFORMER: 1200LBS
B. AHU
 - REFER TO ARCHITECTURAL DRAWINGS FOR THE FOLLOWING INFORMATION:
A. ALL FINISHED FLOOR ELEVATIONS
B. LOCATION AND POSITION IN PLAN OF ALL
 - CHANGES IN ELEVATION
 - SLAB OPENING'S SIZE AND LOCATION
 - WALL LOCATIONS
 - INSERTS FOR THE ATTACHMENT OF NON-STRUCTURAL ITEMS ARE TO BE SUPPLIED BY THE NON-STRUCTURAL TRADE INVOLVED. LOCATION AND PLACEMENT WITHIN THE CONCRETE STRUCTURE SHALL NOT DISPLACE REINFORCEMENT STEEL. ALL INSERTS NOT SATISFACTORY TO QUINN DRESSSEL ASSOCIATES WILL BE REMOVED AT NO COST.
 - SHOP DRAWINGS, SLEEVING DRAWINGS, CONDUIT LAYOUT DRAWINGS AND THE LIKE SHALL ACCURATELY INDICATE THE SIZE LOCATION AND EXTENT OF SUCH ITEMS. ALL SUCH DRAWINGS SHALL BE SUBMITTED TO THE CONSULTANTS MINIMUM 4 WEEKS PRIOR TO CONCRETE SLAB POURS.

1 2024-09-25 ISSUED FOR PERMIT
2 2024-10-28 ISSUED FOR CONSTRUCTION
3 2025-01-23 ISSUED FOR COORDINATION

Quinn Dressel
ASSOCIATES
CONSULTING STRUCTURAL ENGINEERS

RAIMONDO
+ ASSOCIATES
ARCHITECTS INC.

4687 Queen Street Suite 2,
Niagara Falls, ON, L2E 2L9
T | 905-357-4441
F | 905-357-9203
W | www.raidmondarchitects.com
E | mail@raidmondarchitects.com

CLIENT NAME
Niagara Adventure Excursion Inc.

PROJECT NAME
Grand View Marketplace
Starbucks

PROJECT ADDRESS
5920 Niagara River Pkwy, Niagara Falls, ON


SHEET NAME
ROOF PLAN

DRAWN BY: JC
DATE: 2025-01-23 10:50:43 AM
SCALE: As indicated
PROJECT NO.: 24-094
CHECKED: RY


DRAWINGS ARE NOT VALID FOR CONSTRUCTION UNTIL SEALED AND SIGNED BY THE ARCHITECT.
DO NOT SCALE DRAWINGS. REPORT ALL DISCREPANCIES TO THE ARCHITECT BEFORE PROCEEDING. ALL DRAWINGS AND DESIGNS REMAIN THE PROPERTY OF THE ARCHITECT, AND ARE PROTECTED UNDER COPYRIGHT.
THESE DESIGN DOCUMENTS ARE PREPARED SOLELY FOR THE USE BY THE PARTY WITH WHOM THE DESIGN PROFESSIONAL HAS ENTERED INTO A CONTRACT AND THERE ARE NO REPRESENTATIONS OF ANY KIND MADE BY THE DESIGN PROFESSIONAL TO ANY PARTY WITH WHOM THE DESIGN PROFESSIONAL HAS NOT ENTERED INTO A CONTRACT.

SHEET #
S202
REV. #


G:\Shared drives\Project Drafting\24-494\GD QDA Drafting\24-494\GV Starbucks\Working File\24-494 - NAE - G.V. Marketplace (Starbucks) R25_Structure.rvt

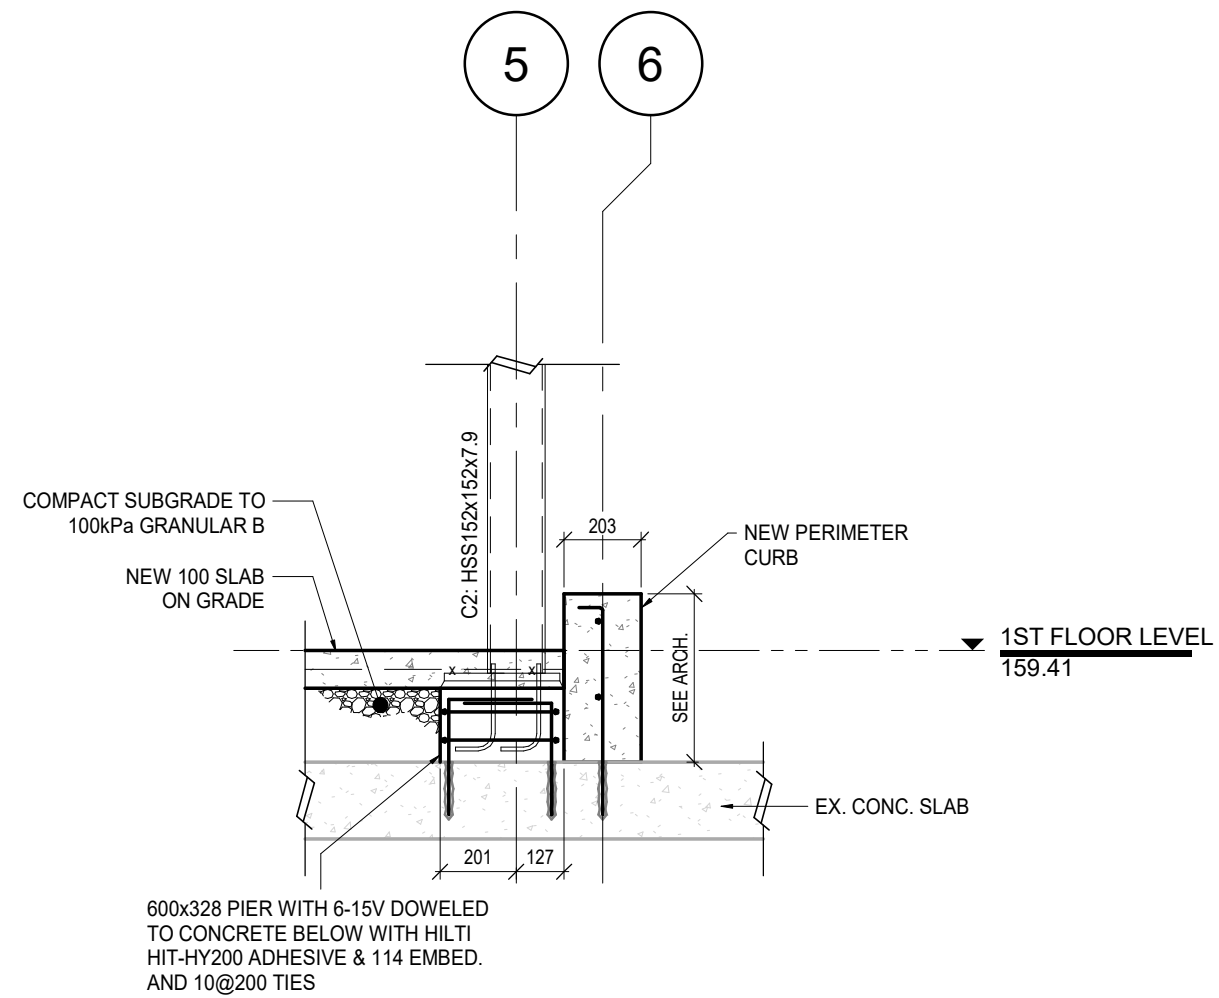


1 SECTION
S401 1 : 20

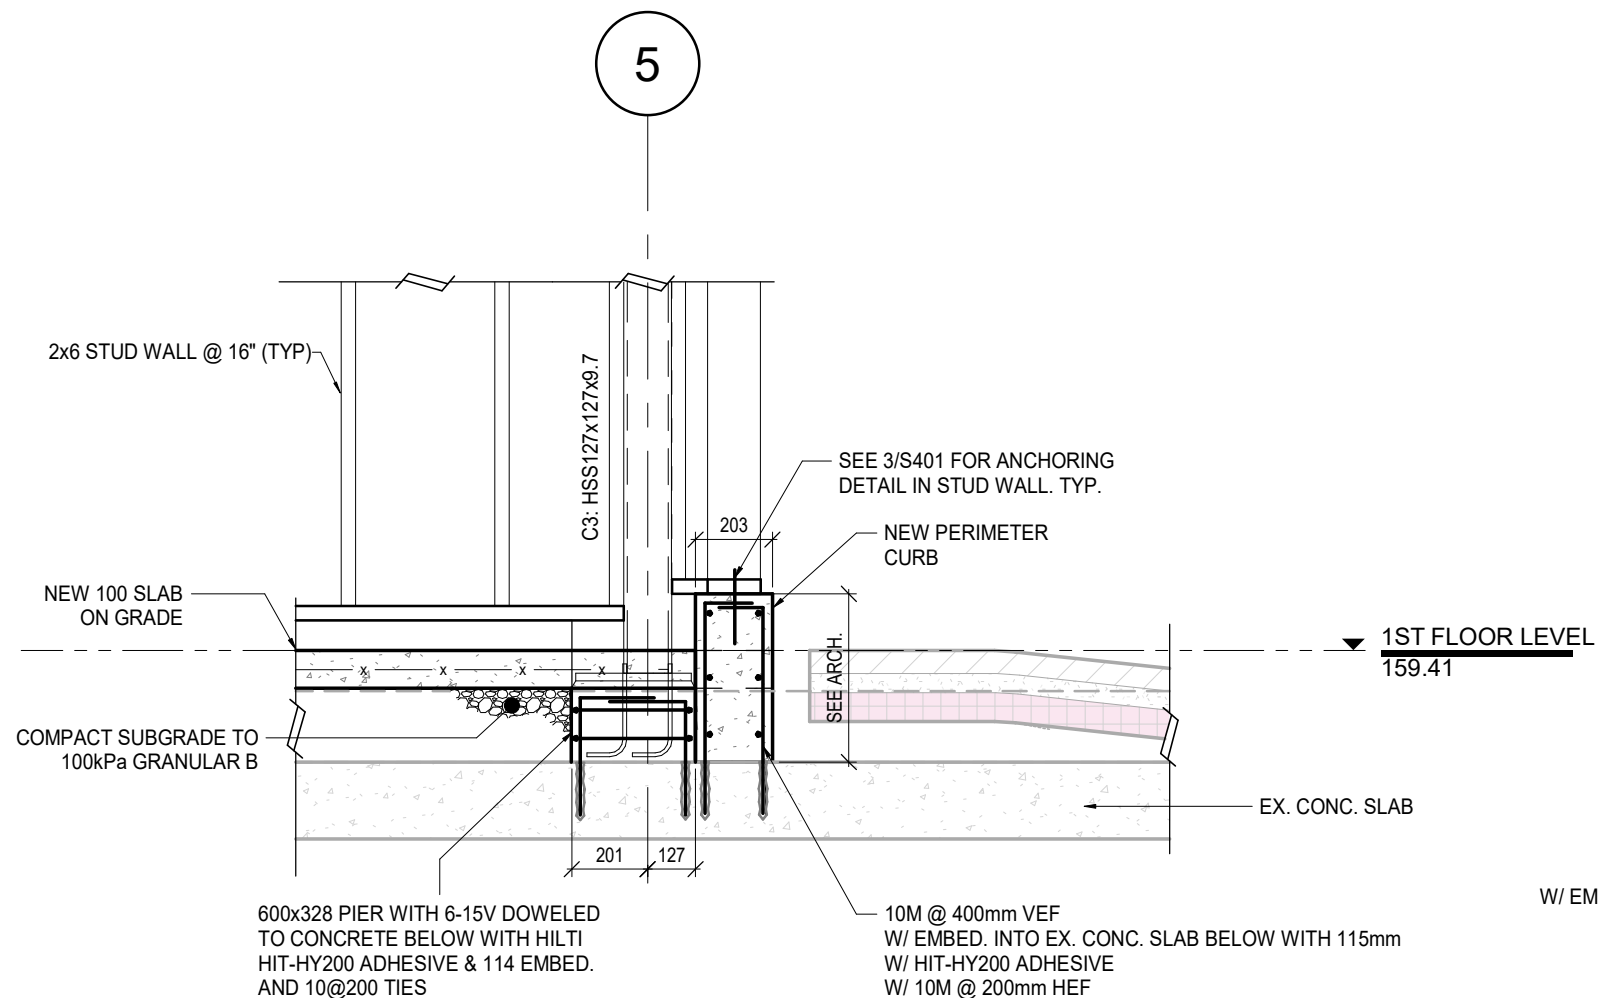


2 SECTION
S401 1 : 20

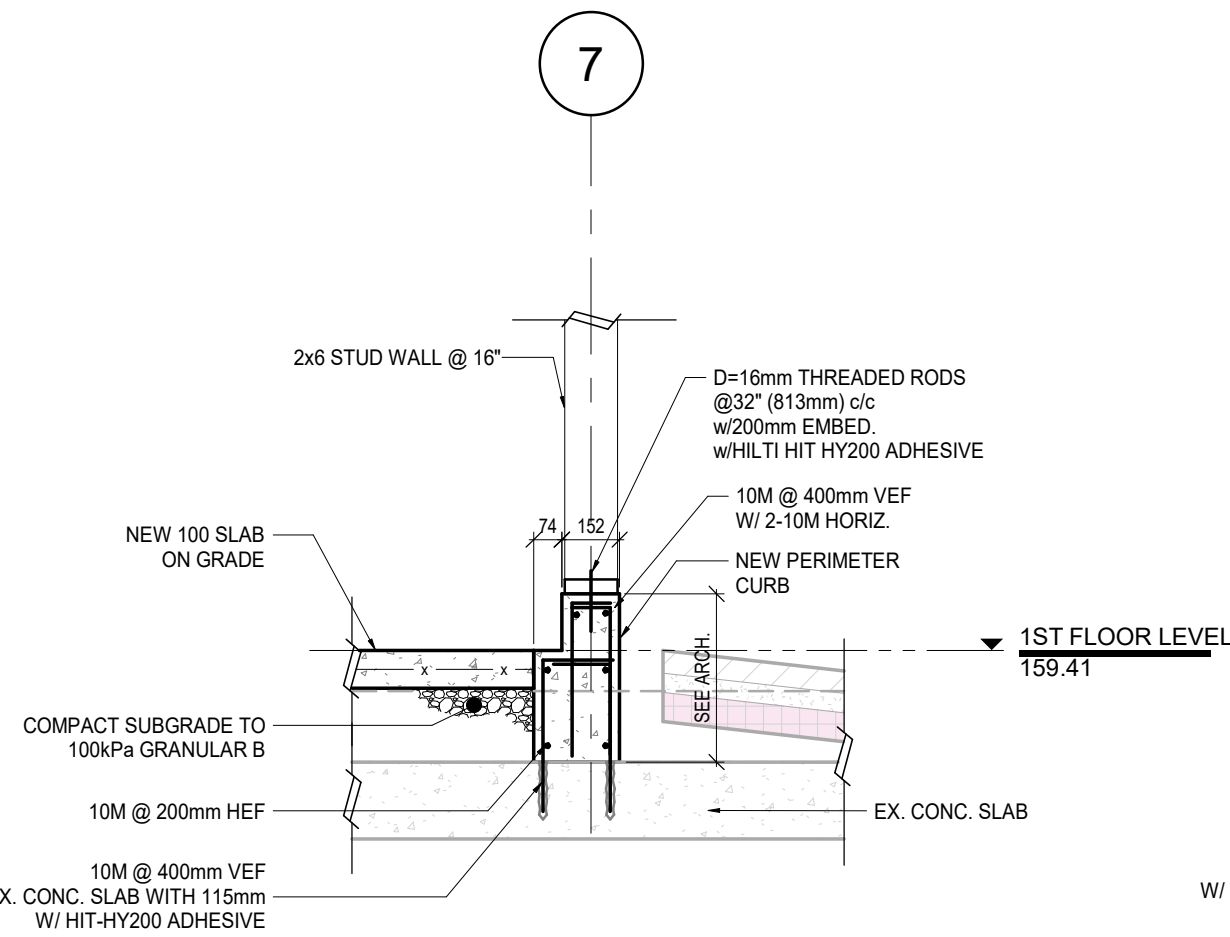


3 SECTION
S401 1 : 20

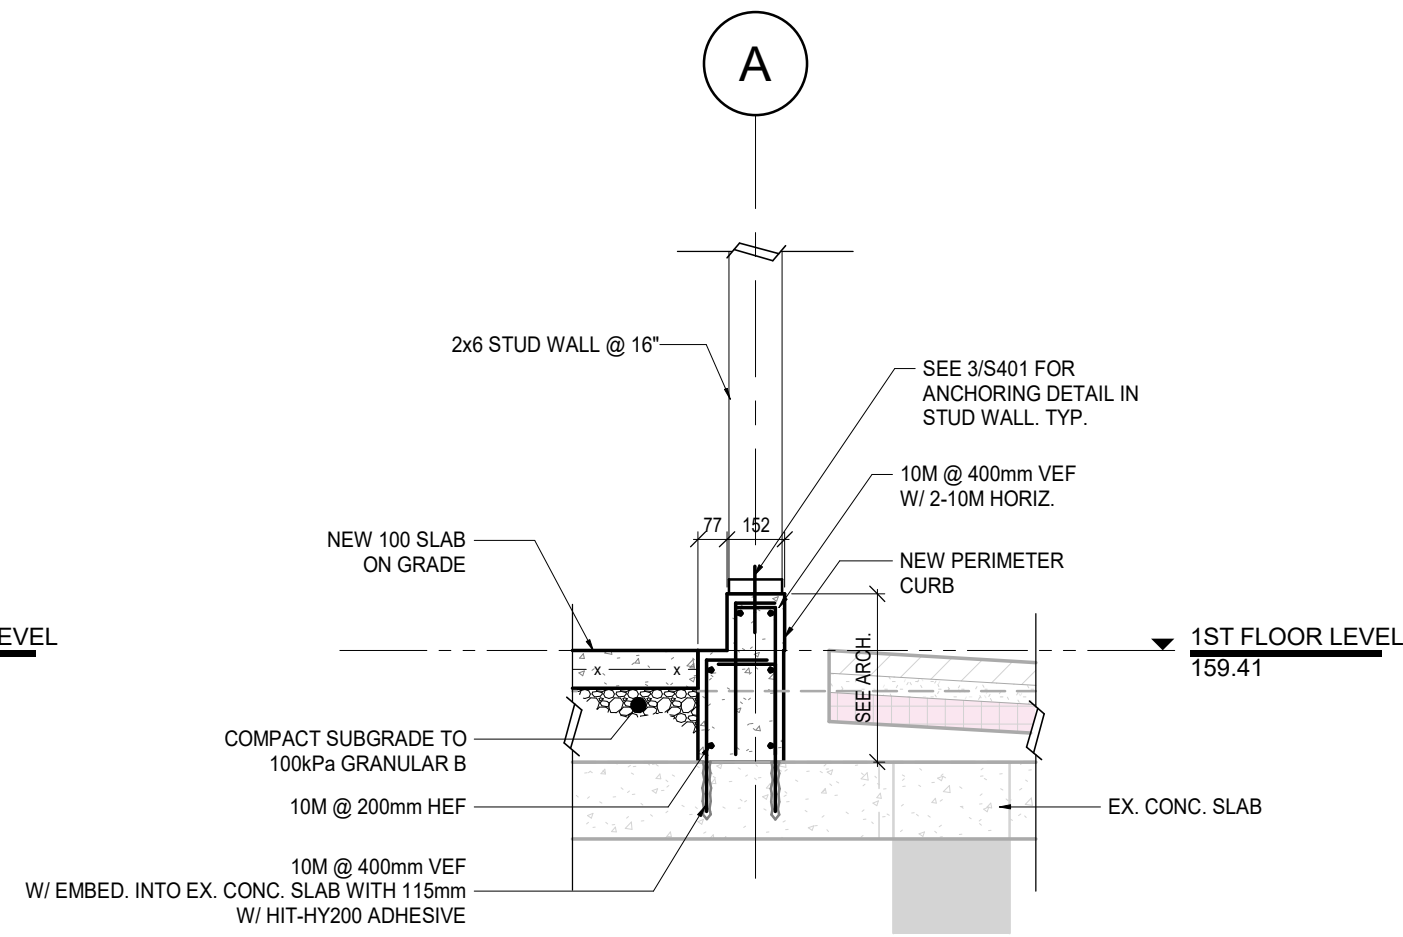


4 SECTION
S401 1 : 20

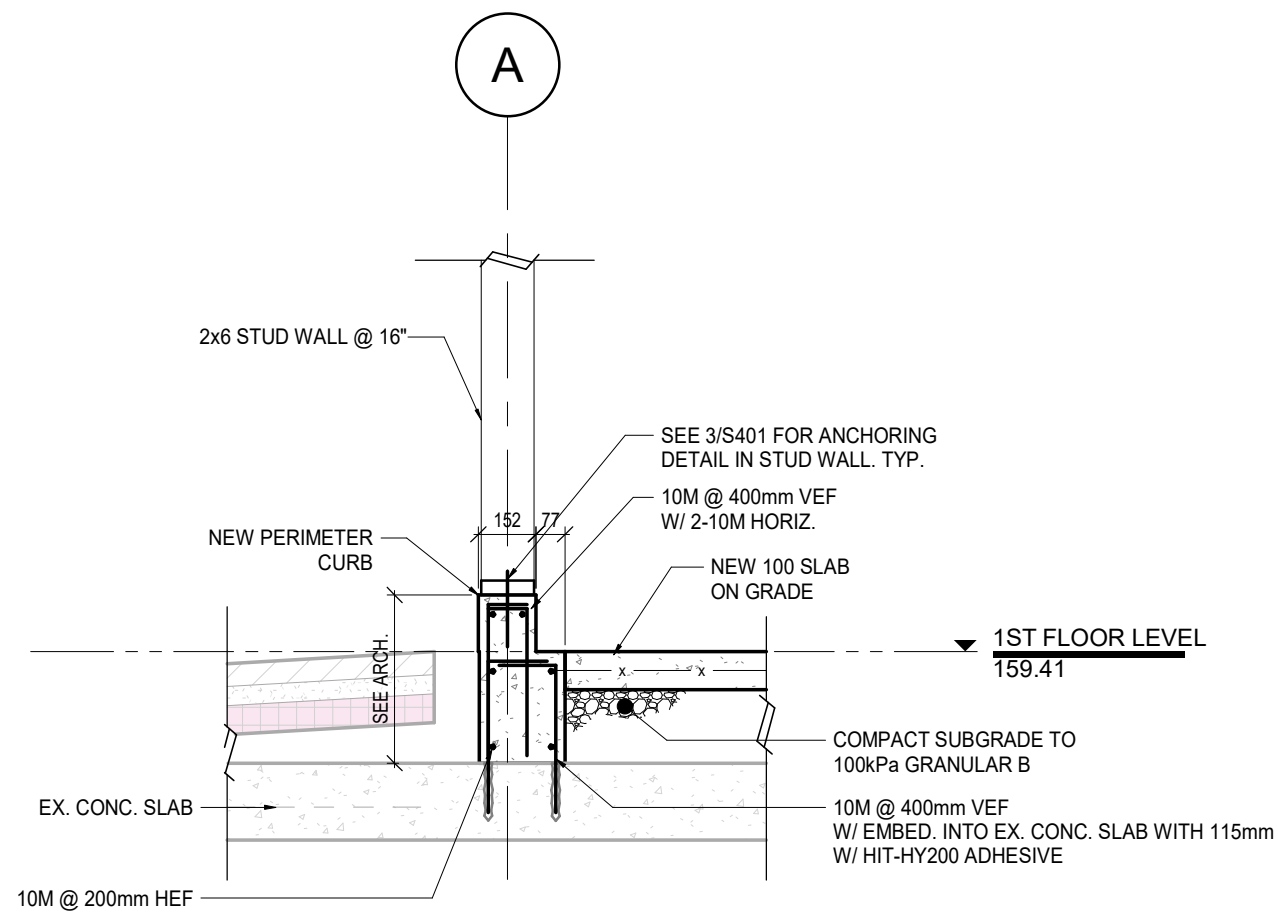


5 SECTION
S401 1 : 20

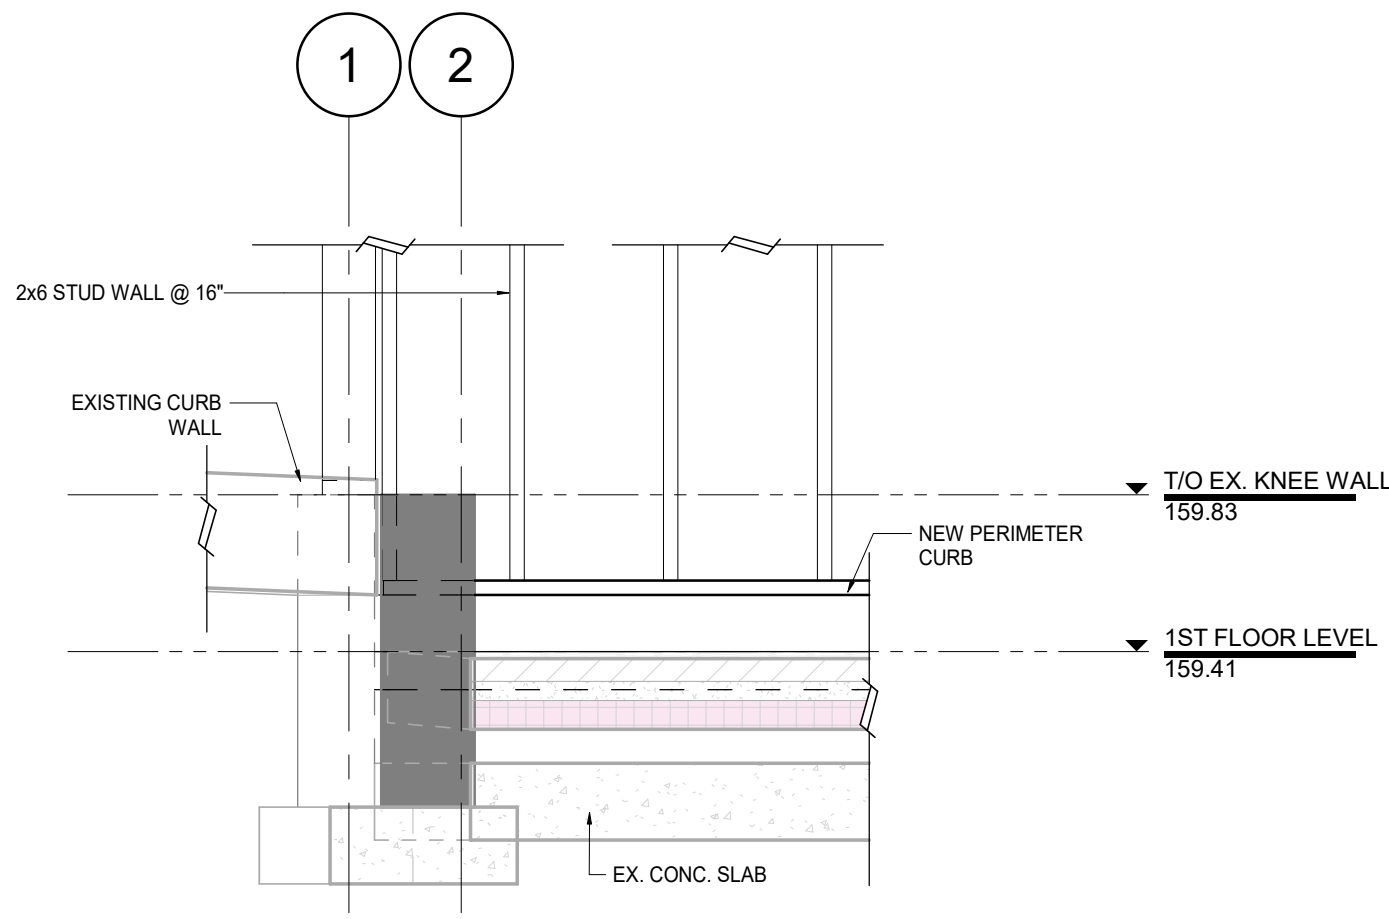


6 SECTION
S401 1 : 20

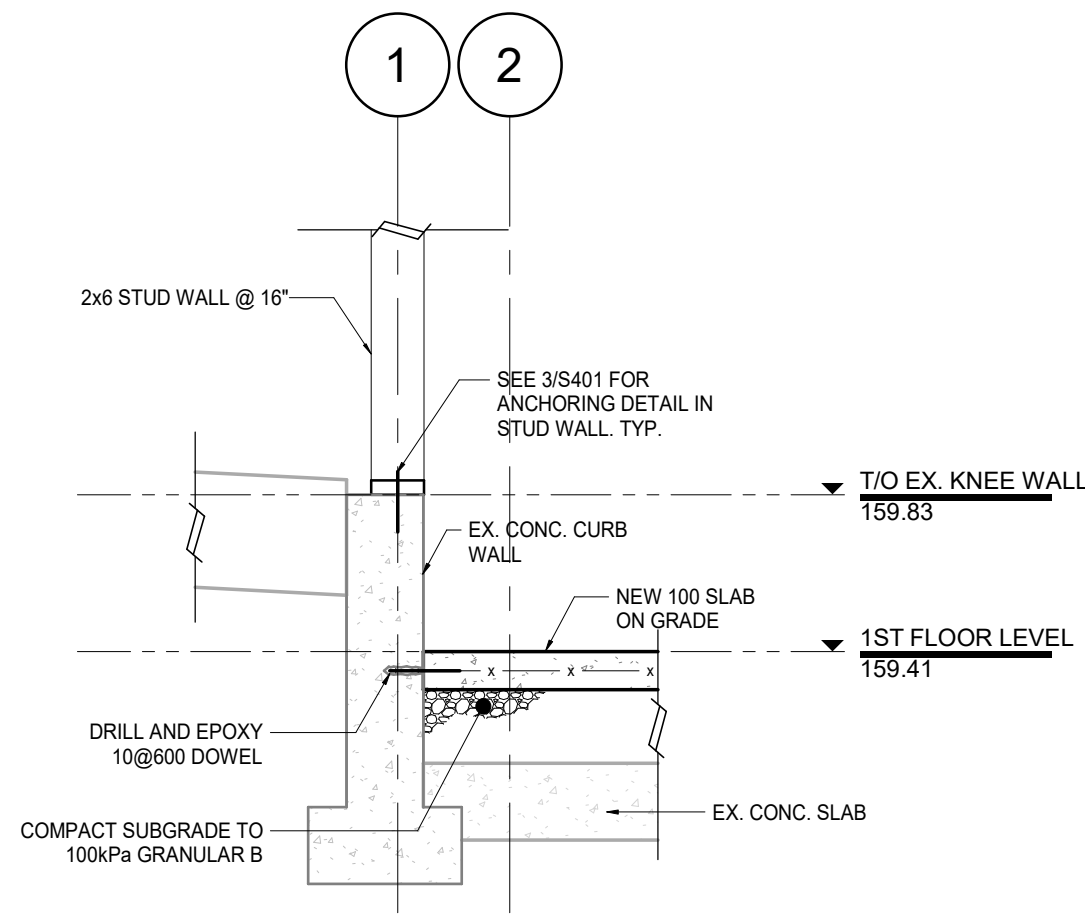


7 SECTION
S401 1 : 20

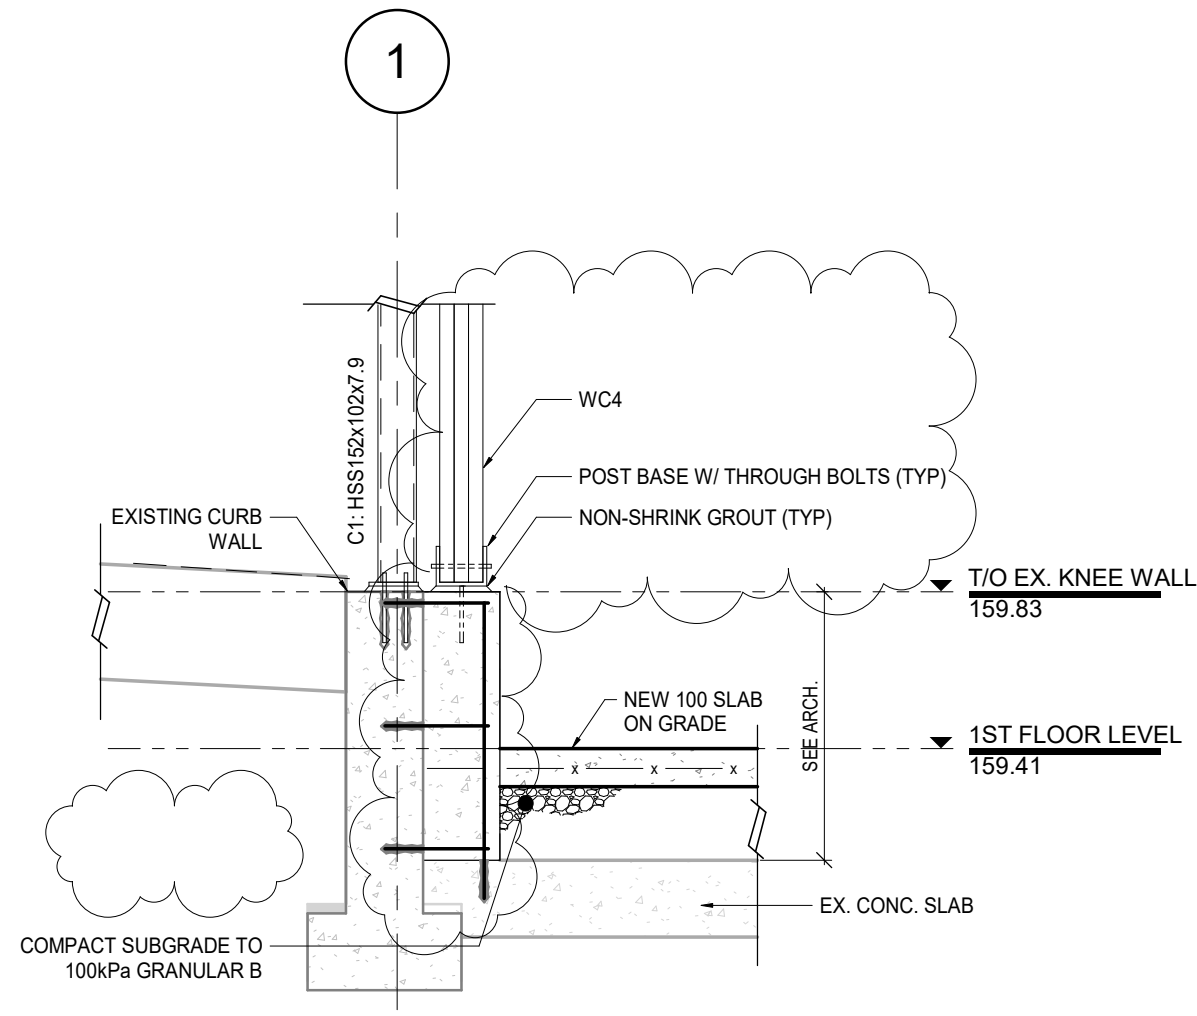


8 SECTION
S401 1 : 20

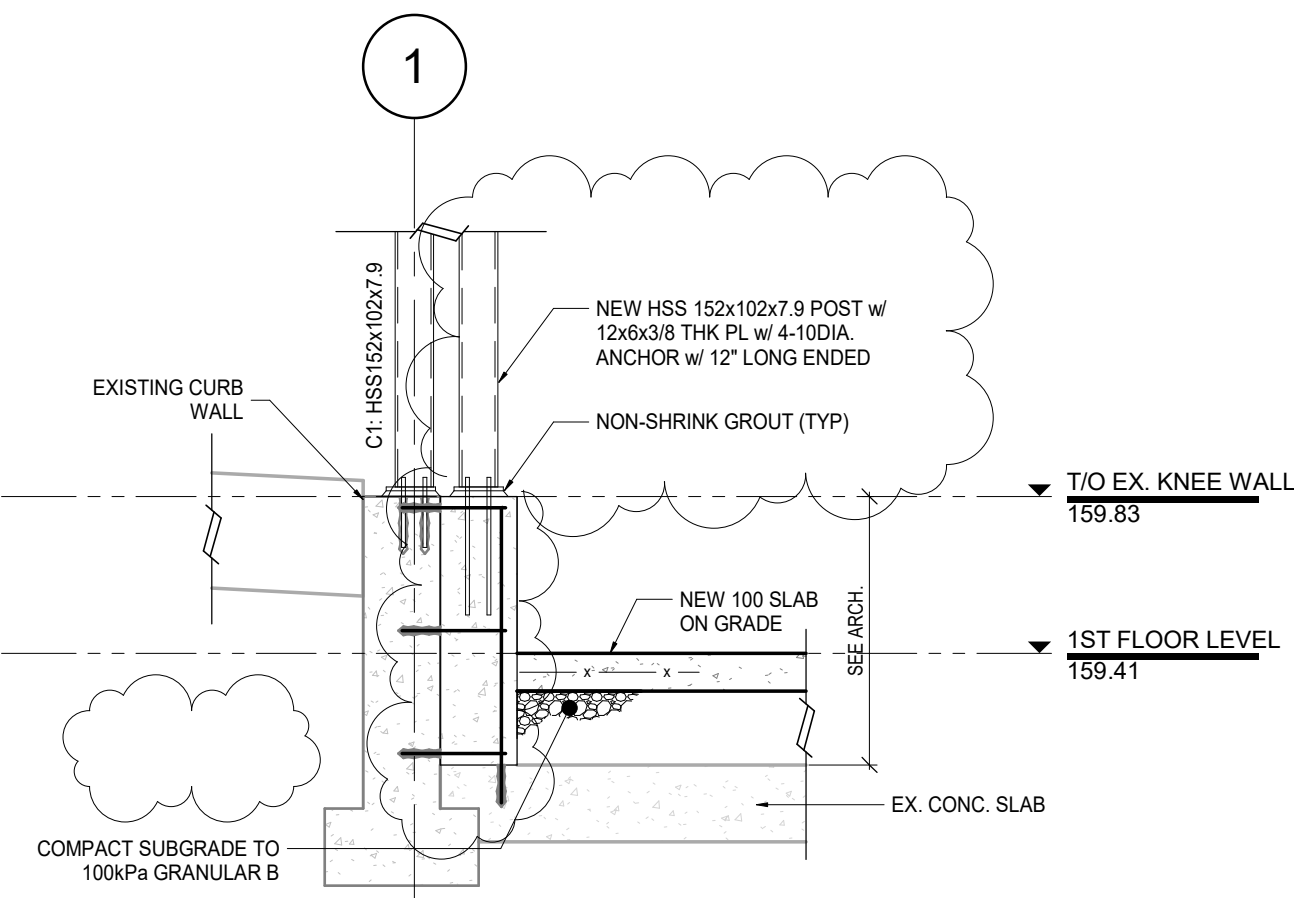

9 SECTION
S401 1 : 20

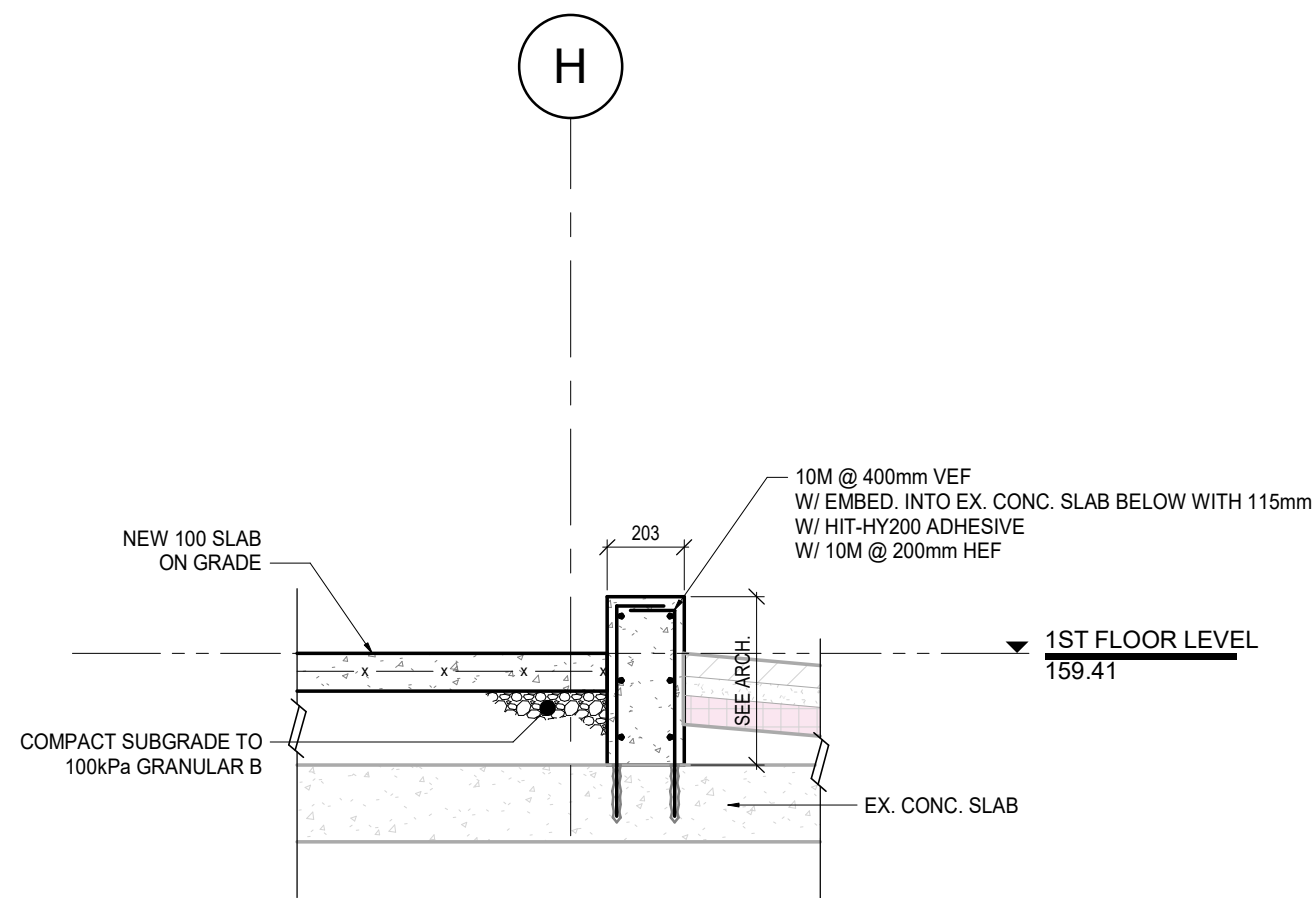

10 SECTION
S401 1 : 20

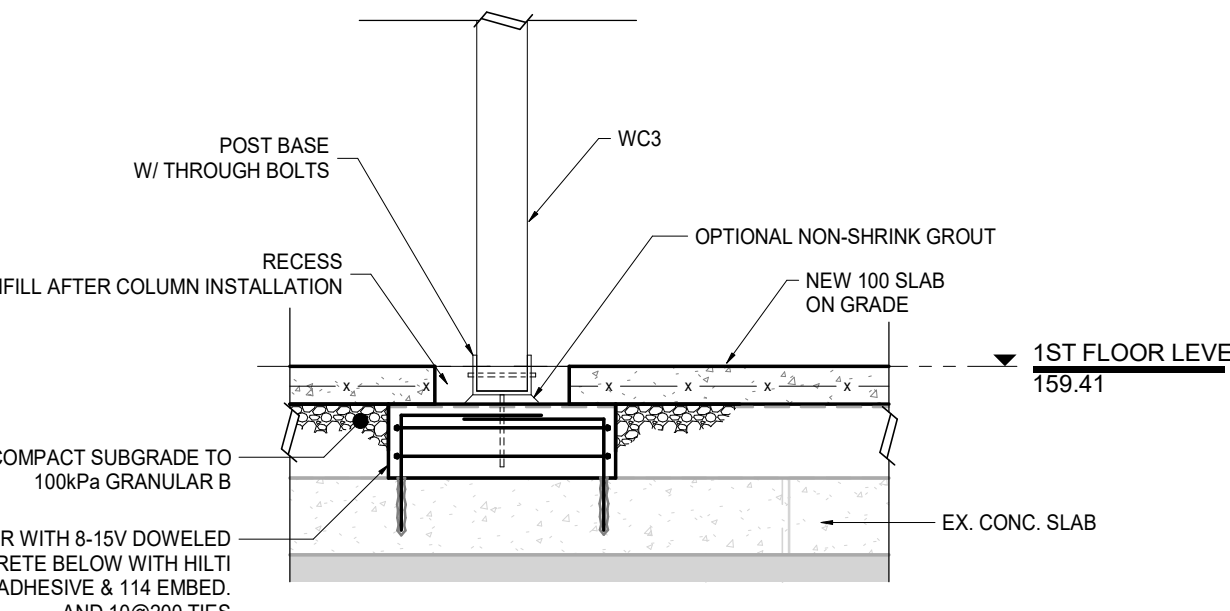

11 SECTION
S401 1 : 20

NOTES:
X-RAY OR REBAR SCAN EXISTING CONCRETE SLABS, BEAMS AND COLUMNS TO LOCATE EXISTING REINFORCING STEEL, STIRRUPS, TIES, AND CONDUITS. DO NOT DRILL THROUGH ANY EXISTING REINFORCEMENT AND DO NOT CUT ANY EXISTING CONDUITS.

ALL EXISTING INFORMATION SHOWN ON DRAWINGS IS TRANSFERRED FROM EXISTING BASE BUILDING DRAWINGS. CONTRACTOR SHALL BE RESPONSIBLE TO SITE VERIFY THE ACCURACY OF THESE DOCUMENTS WITH AS-BUILT CONDITIONS. ALL DETERMINATION OF EXISTING CONDITIONS MUST BE MADE PRIOR TO ANY STRUCTURAL DEMOLITION.

1	2024-09-25	ISSUED FOR PERMIT
2	2024-10-28	ISSUED FOR CONSTRUCTION
3	2025-01-23	ISSUED FOR COORDINATION



CLIENT NAME

Niagara Adventure Excursion Inc.

PROJECT NAME

Grand View Marketplace Starbucks

PROJECT ADDRESS

5920 Niagara River Pkwy, Niagara Falls, ON

SHEET NAME

SECTIONS

DRAWN BY:	JC
DATE:	2025-01-23 10:50:44 AM
SCALE:	1 : 20
PROJECT NO.:	24-094
CHECKED:	RY

DRAWINGS ARE NOT VALID FOR CONSTRUCTION UNTIL SEALED AND SIGNED BY THE ARCHITECT.
DO NOT SCALE DRAWINGS. REPORT ALL DISCREPANCIES TO THE ARCHITECT BEFORE PROCEEDING. ALL DRAWINGS AND DESIGNS REMAIN THE PROPERTY OF THE ARCHITECT, AND ARE PROTECTED UNDER COPYRIGHT.


THESE DESIGN DOCUMENTS ARE PREPARED SOLELY FOR THE USE BY THE PARTY WITH WHOM THE DESIGN PROFESSIONAL HAS ENTERED INTO A CONTRACT AND THERE ARE NO REPRESENTATIONS OF ANY KIND MADE BY THE DESIGN PROFESSIONAL TO ANY PARTY WITH WHOM THE DESIGN PROFESSIONAL HAS NOT ENTERED INTO A CONTRACT.

SHEET #


S401

REV. #


G:\Shared drives\Project Drafting\24-494\GD\QA Drafting 24-494 GV Starbucks\Working File\24-494 - NAE - G.V. Marketplace (Starbucks) R25_Structure.rvt

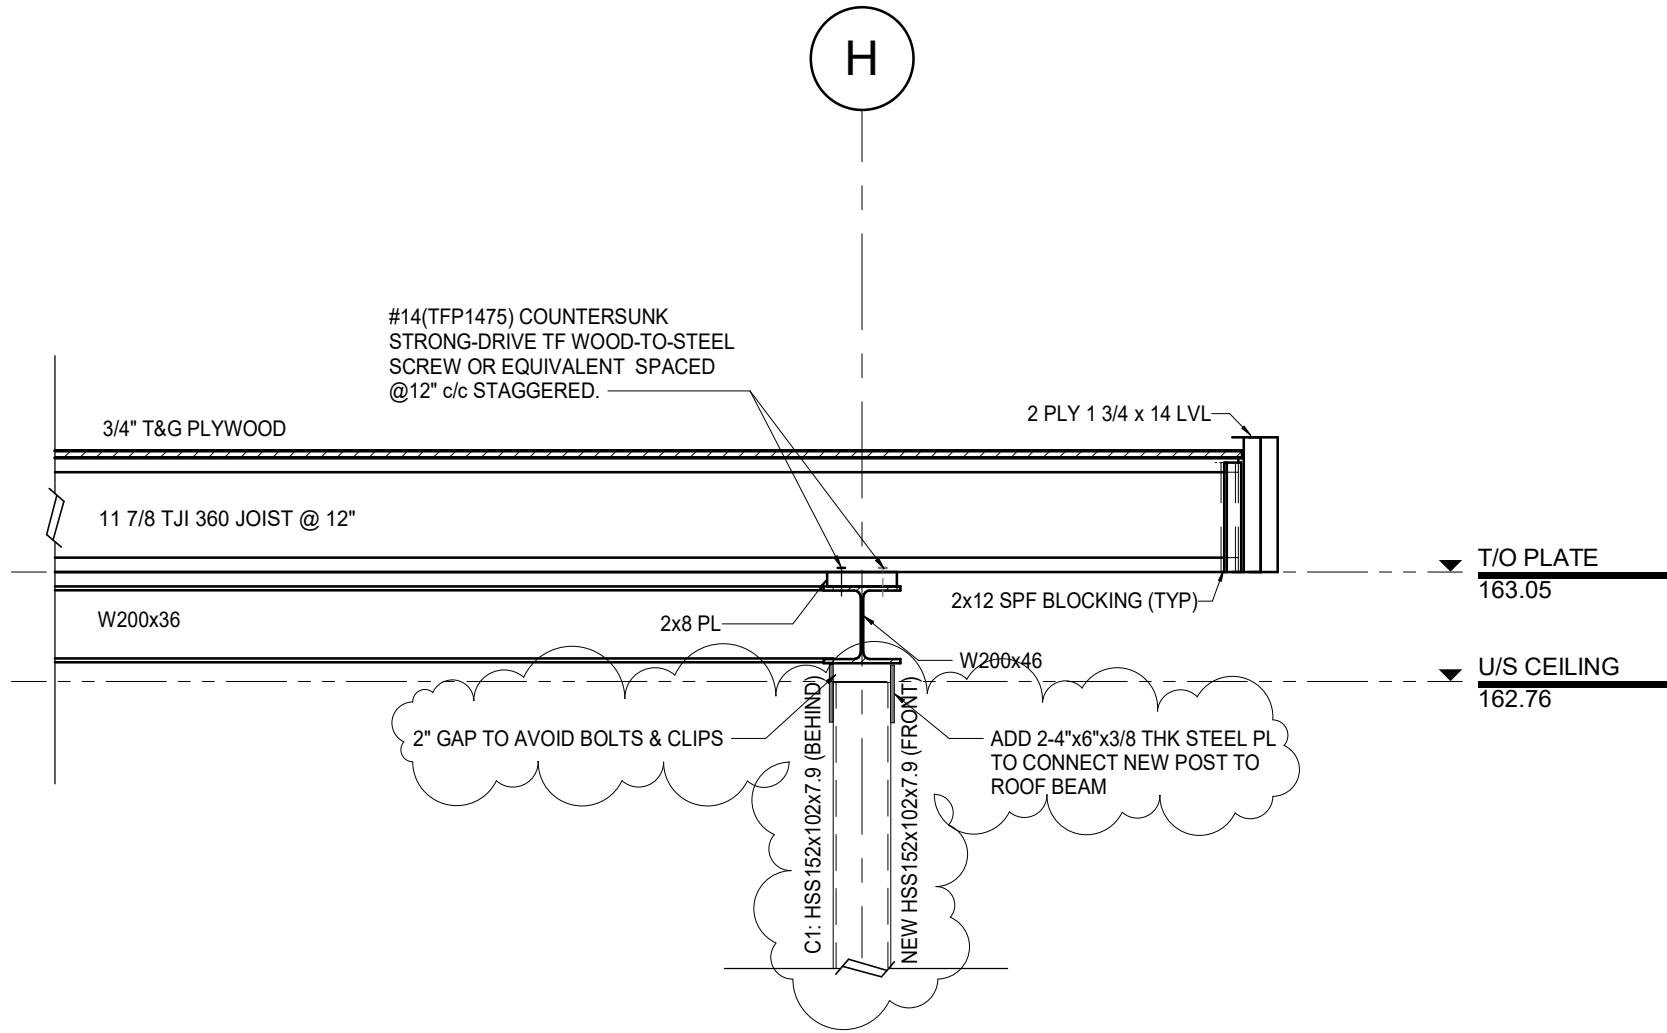


1 SECTION
S402 1 : 20

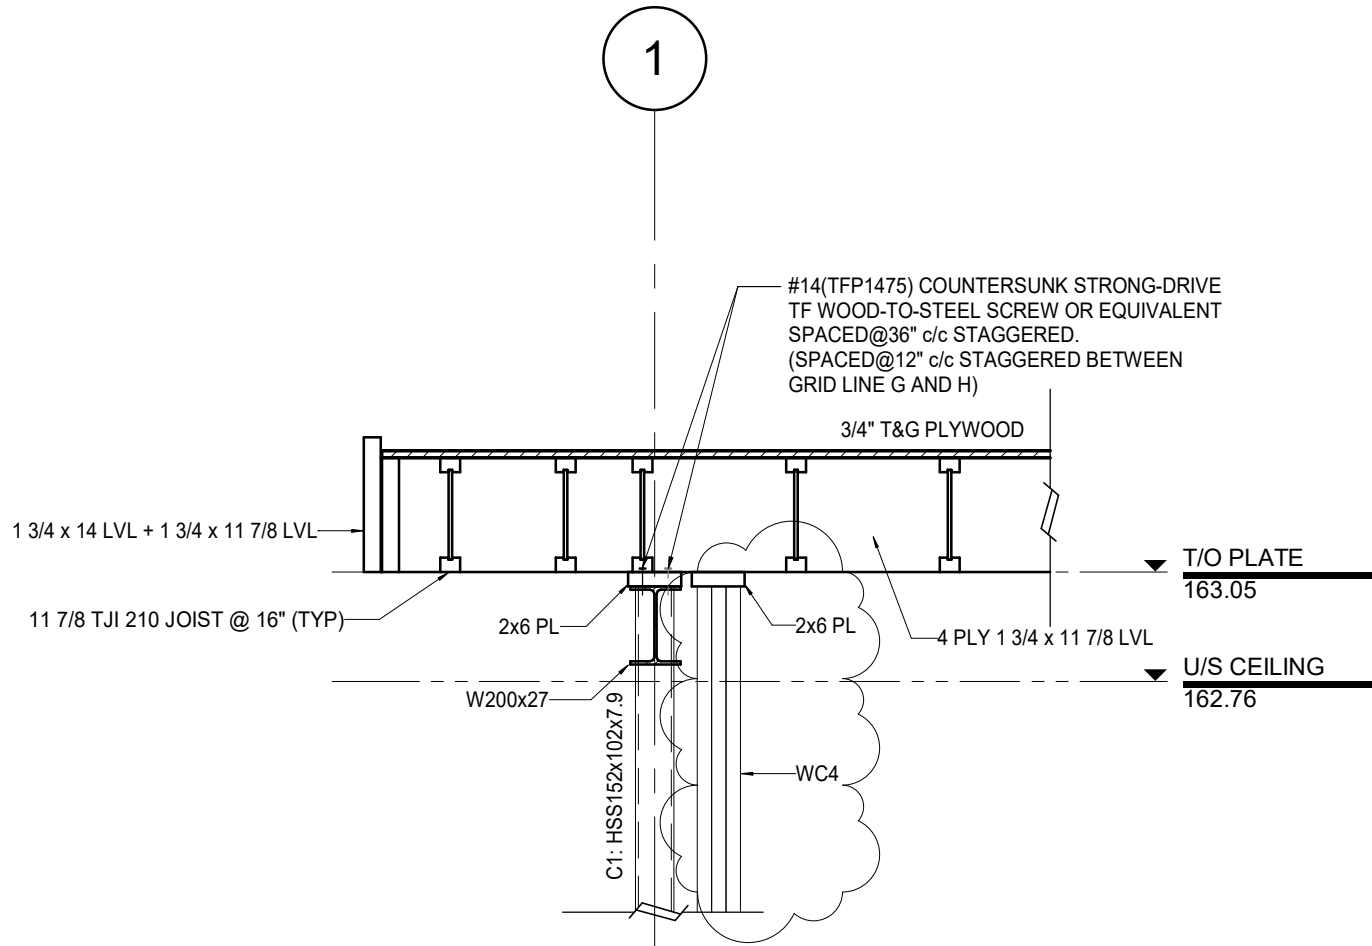


2A SECTION
S402 1 : 20

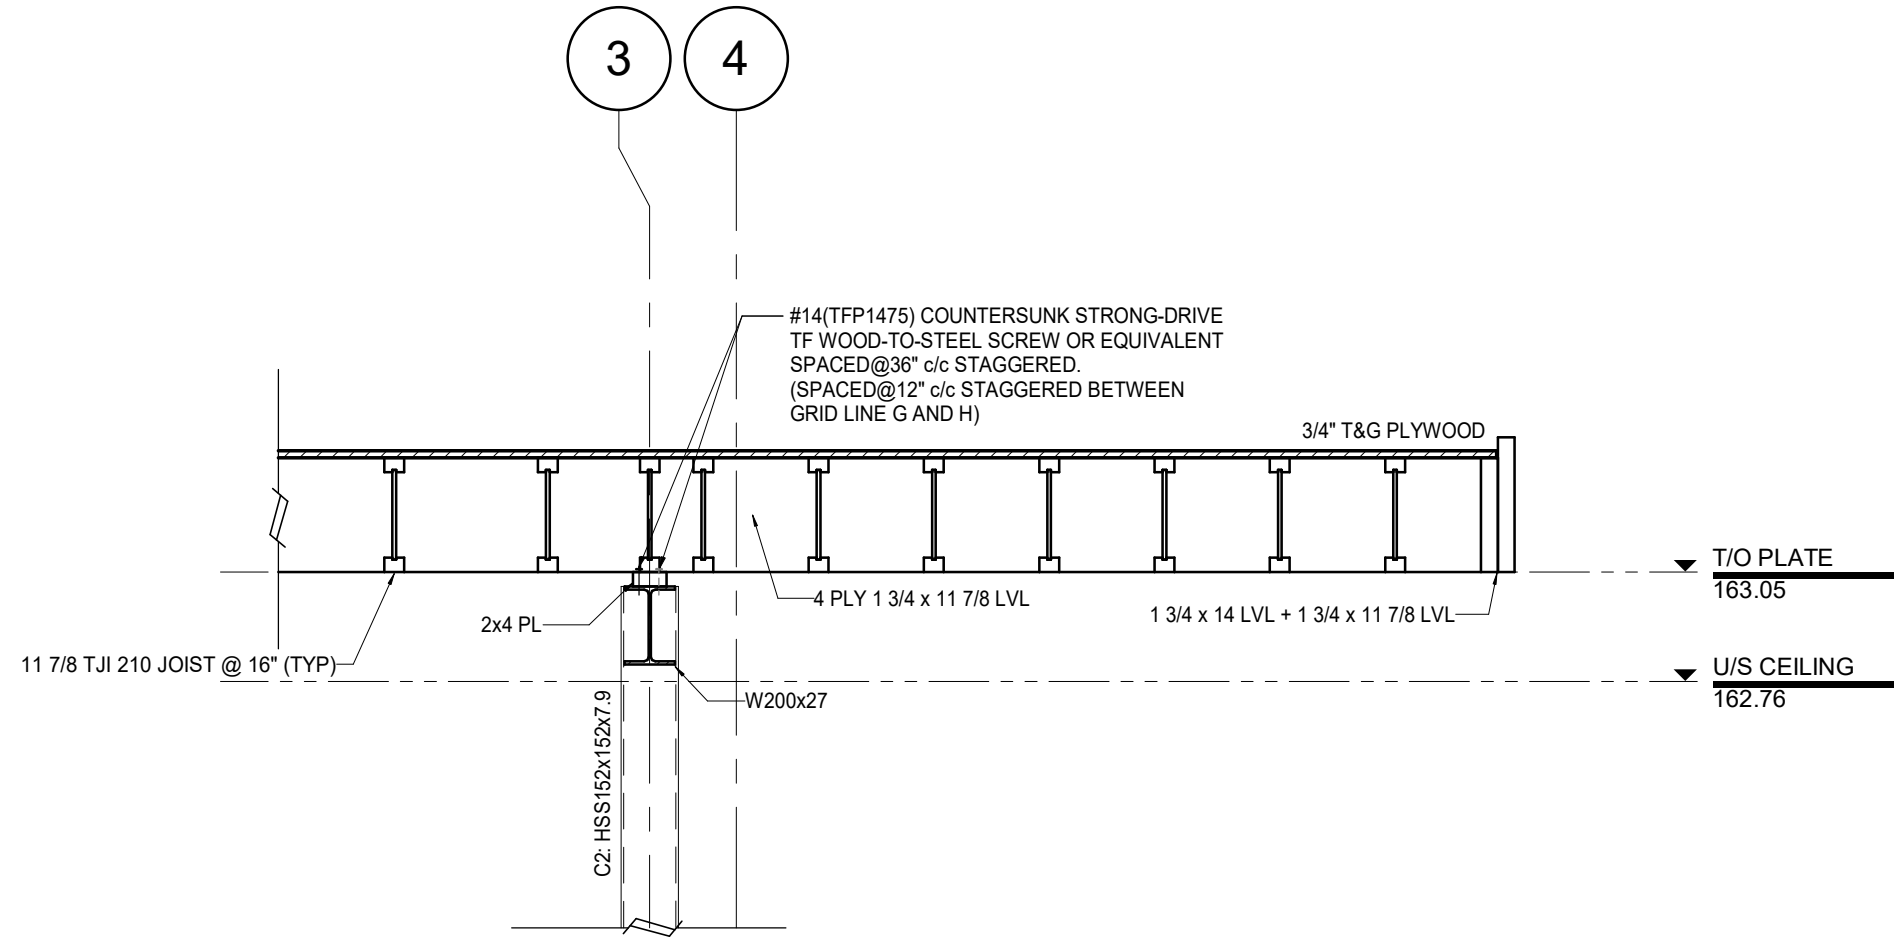


2B SECTION
S402 1 : 20

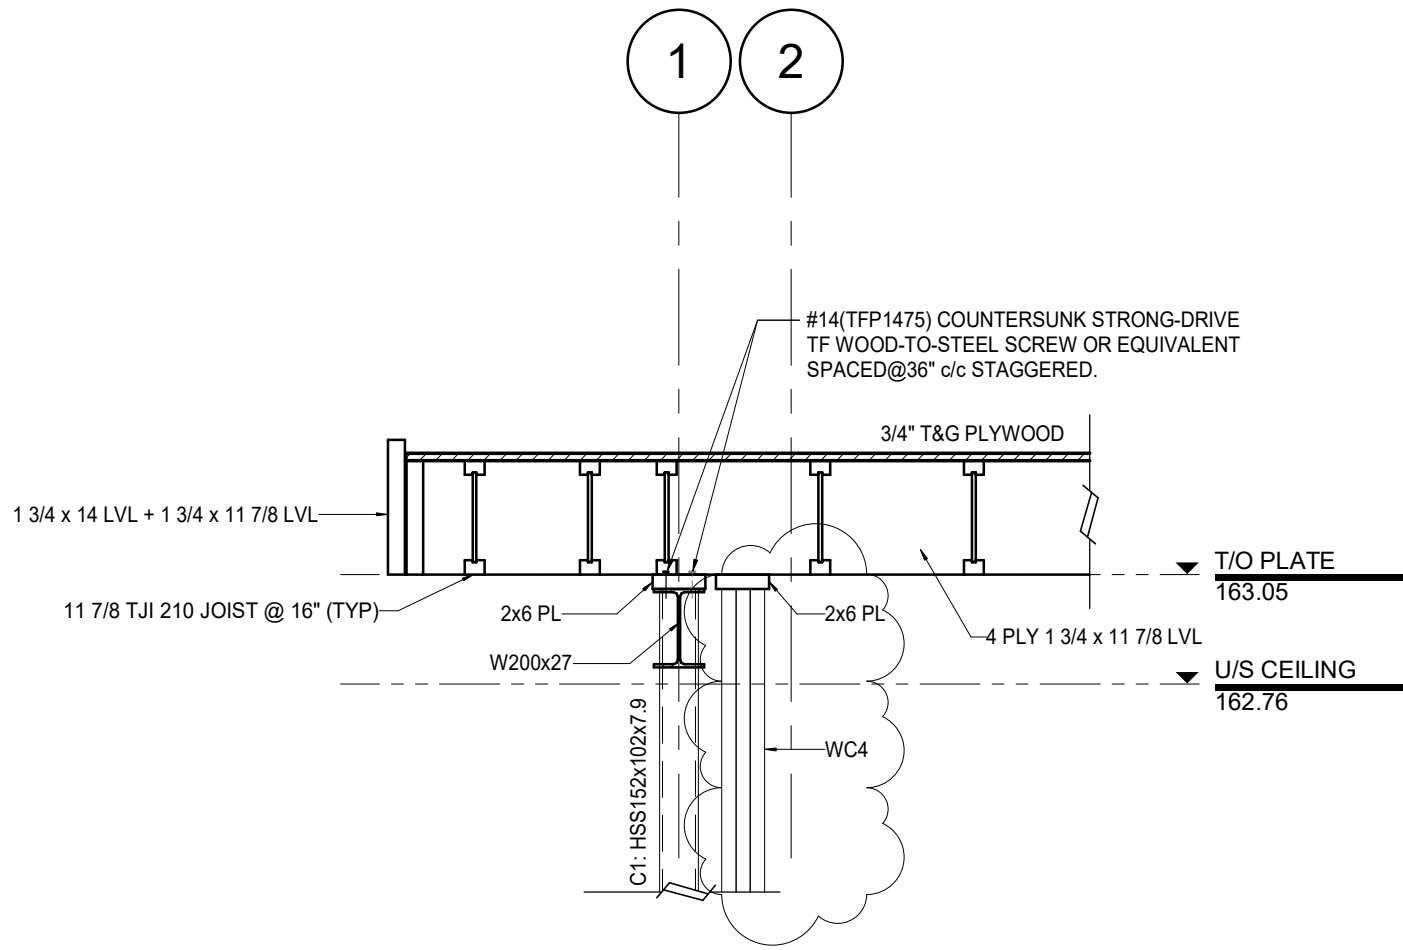

3A SECTION
S402 1 : 20

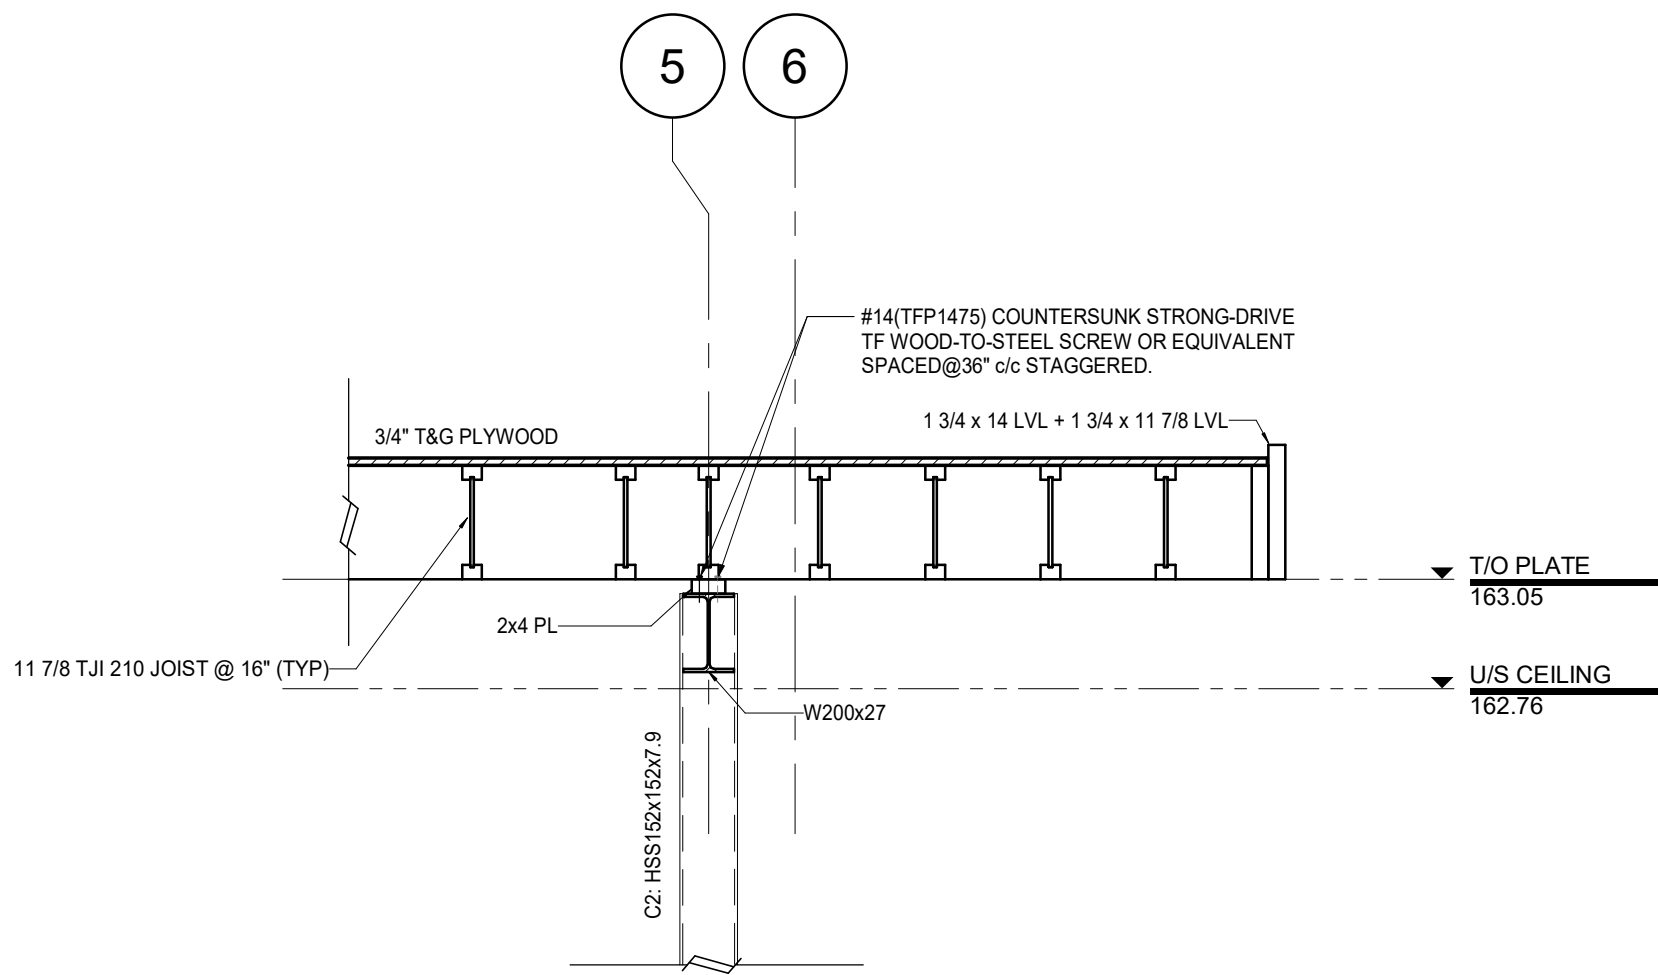

3B SECTION
S402 1 : 20

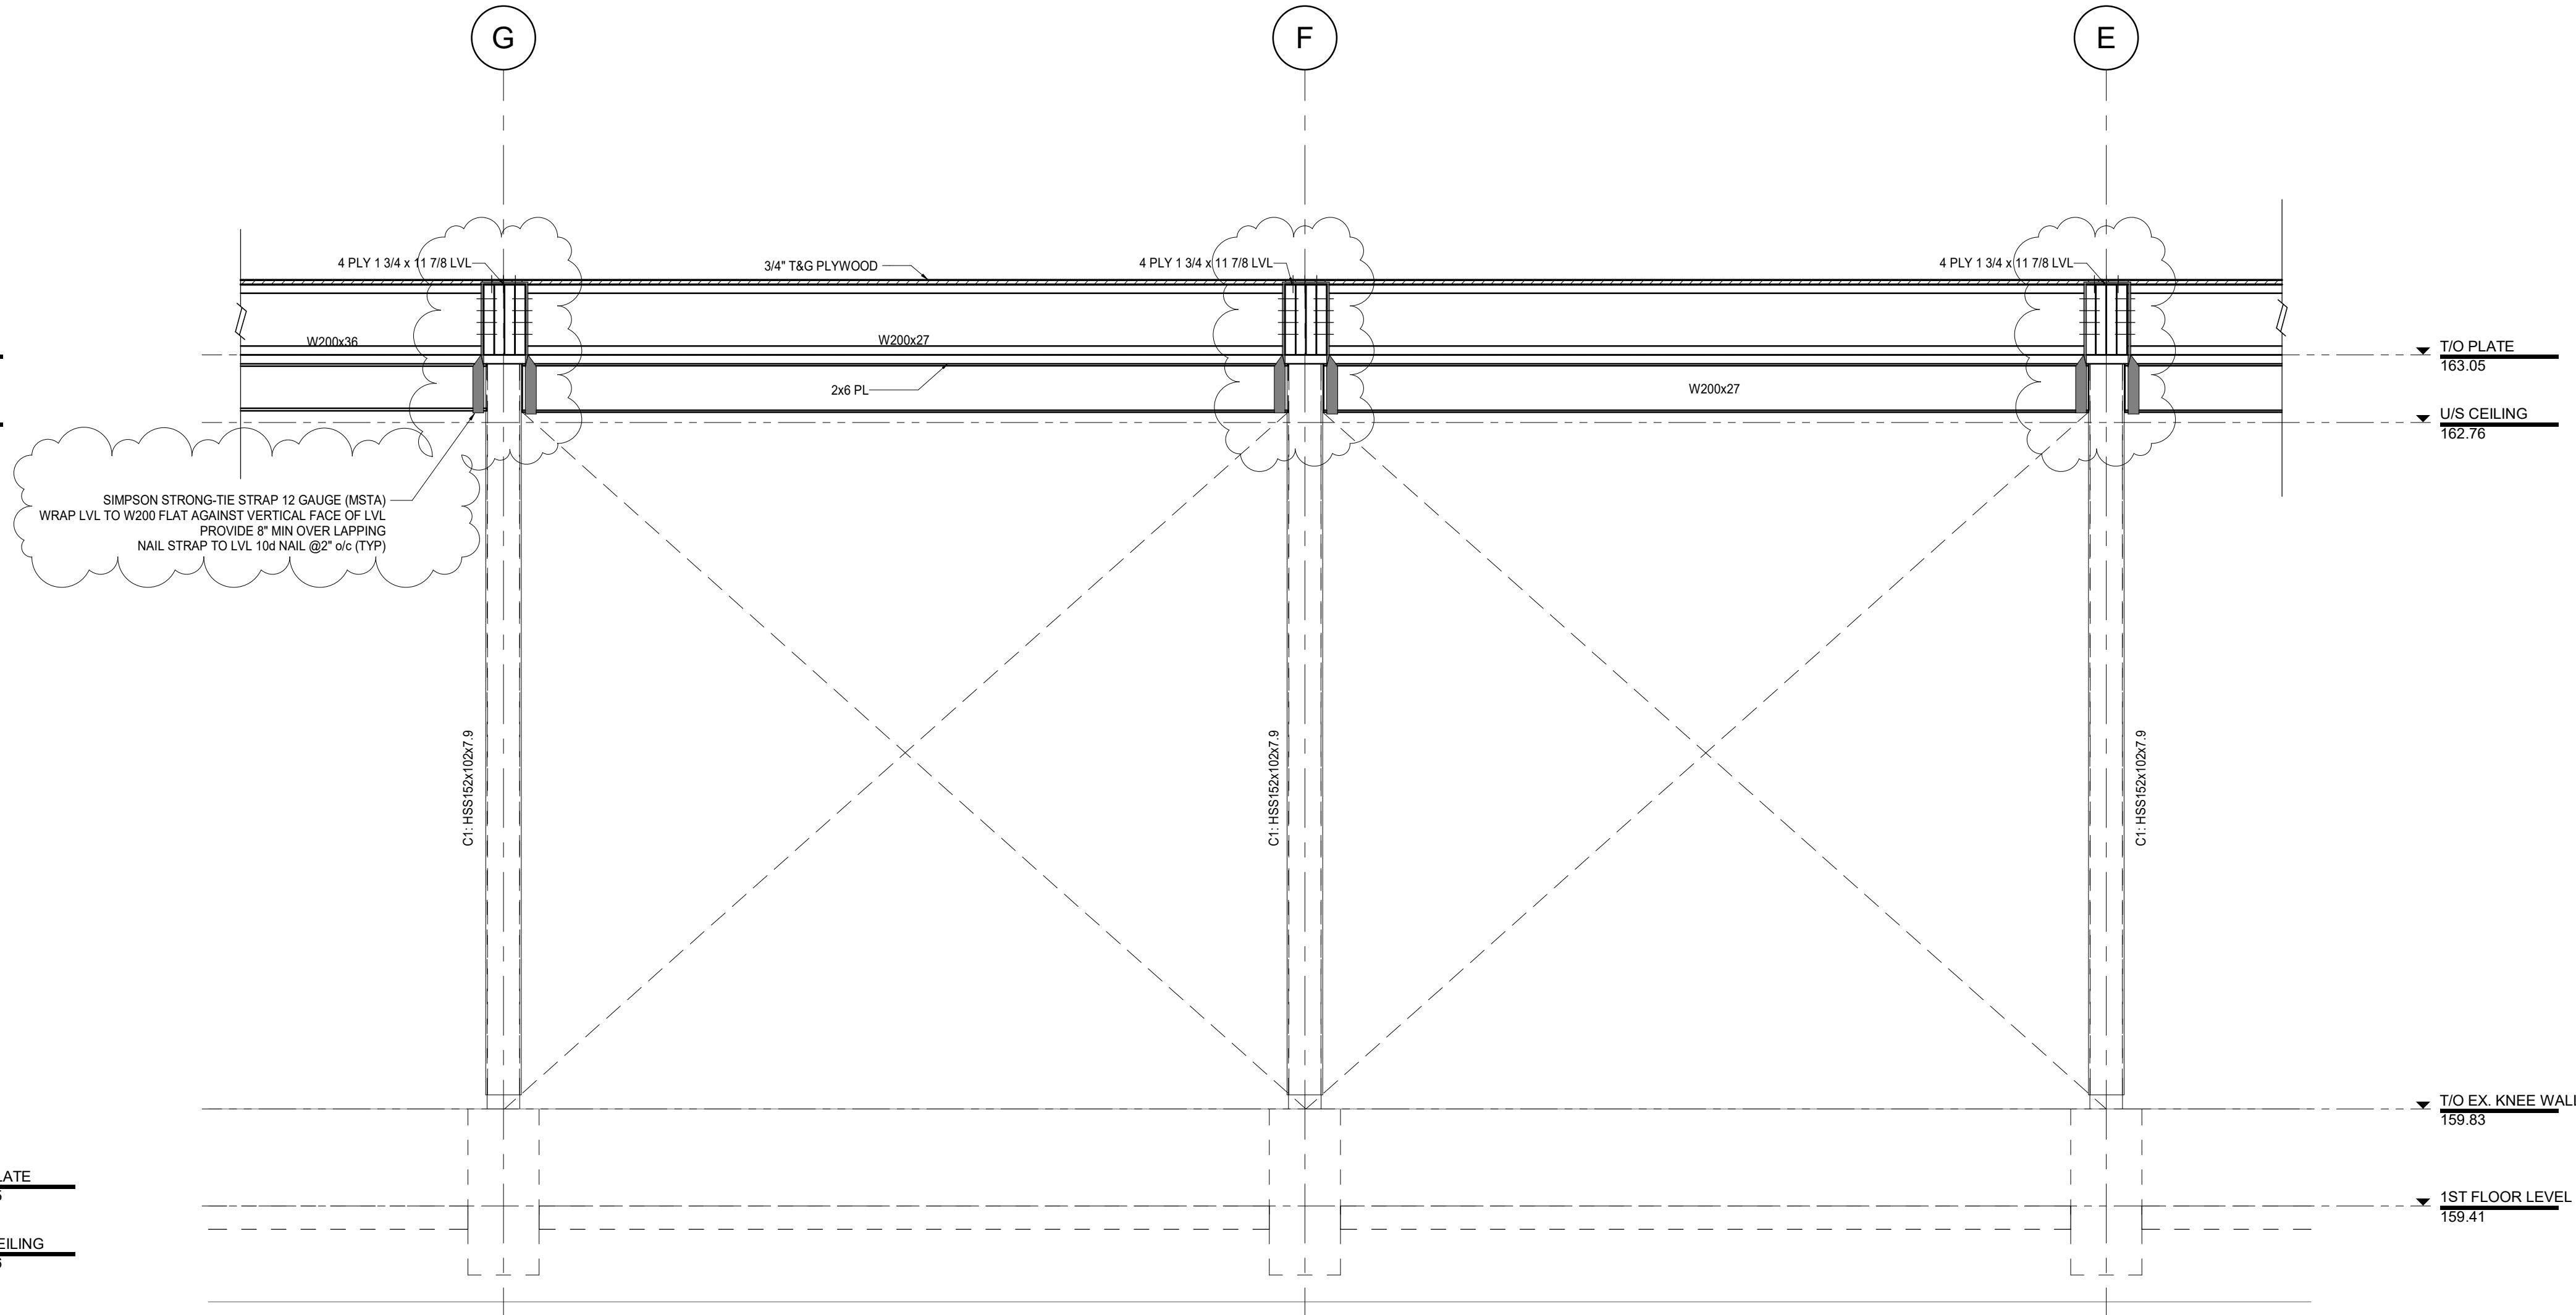

4 SECTION
S402 1 : 20

1	2024-09-25	ISSUED FOR PERMIT
2	2024-10-28	ISSUED FOR CONSTRUCTION
3	2025-01-23	ISSUED FOR COORDINATION



4687 Queen Street Suite 2,
Niagara Falls, ON, L2E 2L9
T | 905-357-4441
F | 905-357-9203
W | www.raidmondarchitects.com
E | mail@raidmondarchitects.com

CLIENT NAME
Niagara Adventure Excursion Inc.

PROJECT NAME
Grand View Marketplace Starbucks

PROJECT ADDRESS
5920 Niagara River Pkwy, Niagara Falls, ON

SHEET NAME
SECTIONS

DRAWN BY: JC
DATE: 2025-01-23 10:50:46 AM
SCALE: 1 : 20
PROJECT NO.: 24-094
CHECKED: RY

DRAWINGS ARE NOT VALID FOR CONSTRUCTION UNTIL SEALED AND SIGNED BY THE ARCHITECT.






THESE DESIGN DOCUMENTS ARE PREPARED SOLELY FOR THE USE BY THE PARTY WITH WHOM THE DESIGN PROFESSIONAL HAS ENTERED INTO A CONTRACT AND THERE ARE NO REPRESENTATIONS OF ANY KIND MADE BY THE DESIGN PROFESSIONAL TO ANY PARTY WITH WHOM THE DESIGN PROFESSIONAL HAS NOT ENTERED INTO A CONTRACT.

SHEET #

S402

REV. #

G:\Shared drives\Project Drafting\24-494\QDA Drafting 24-494 GV Starbucks\Working File\24-494 - NAE - G.V.Marketplace (Starbucks) R25_Structure.rvt

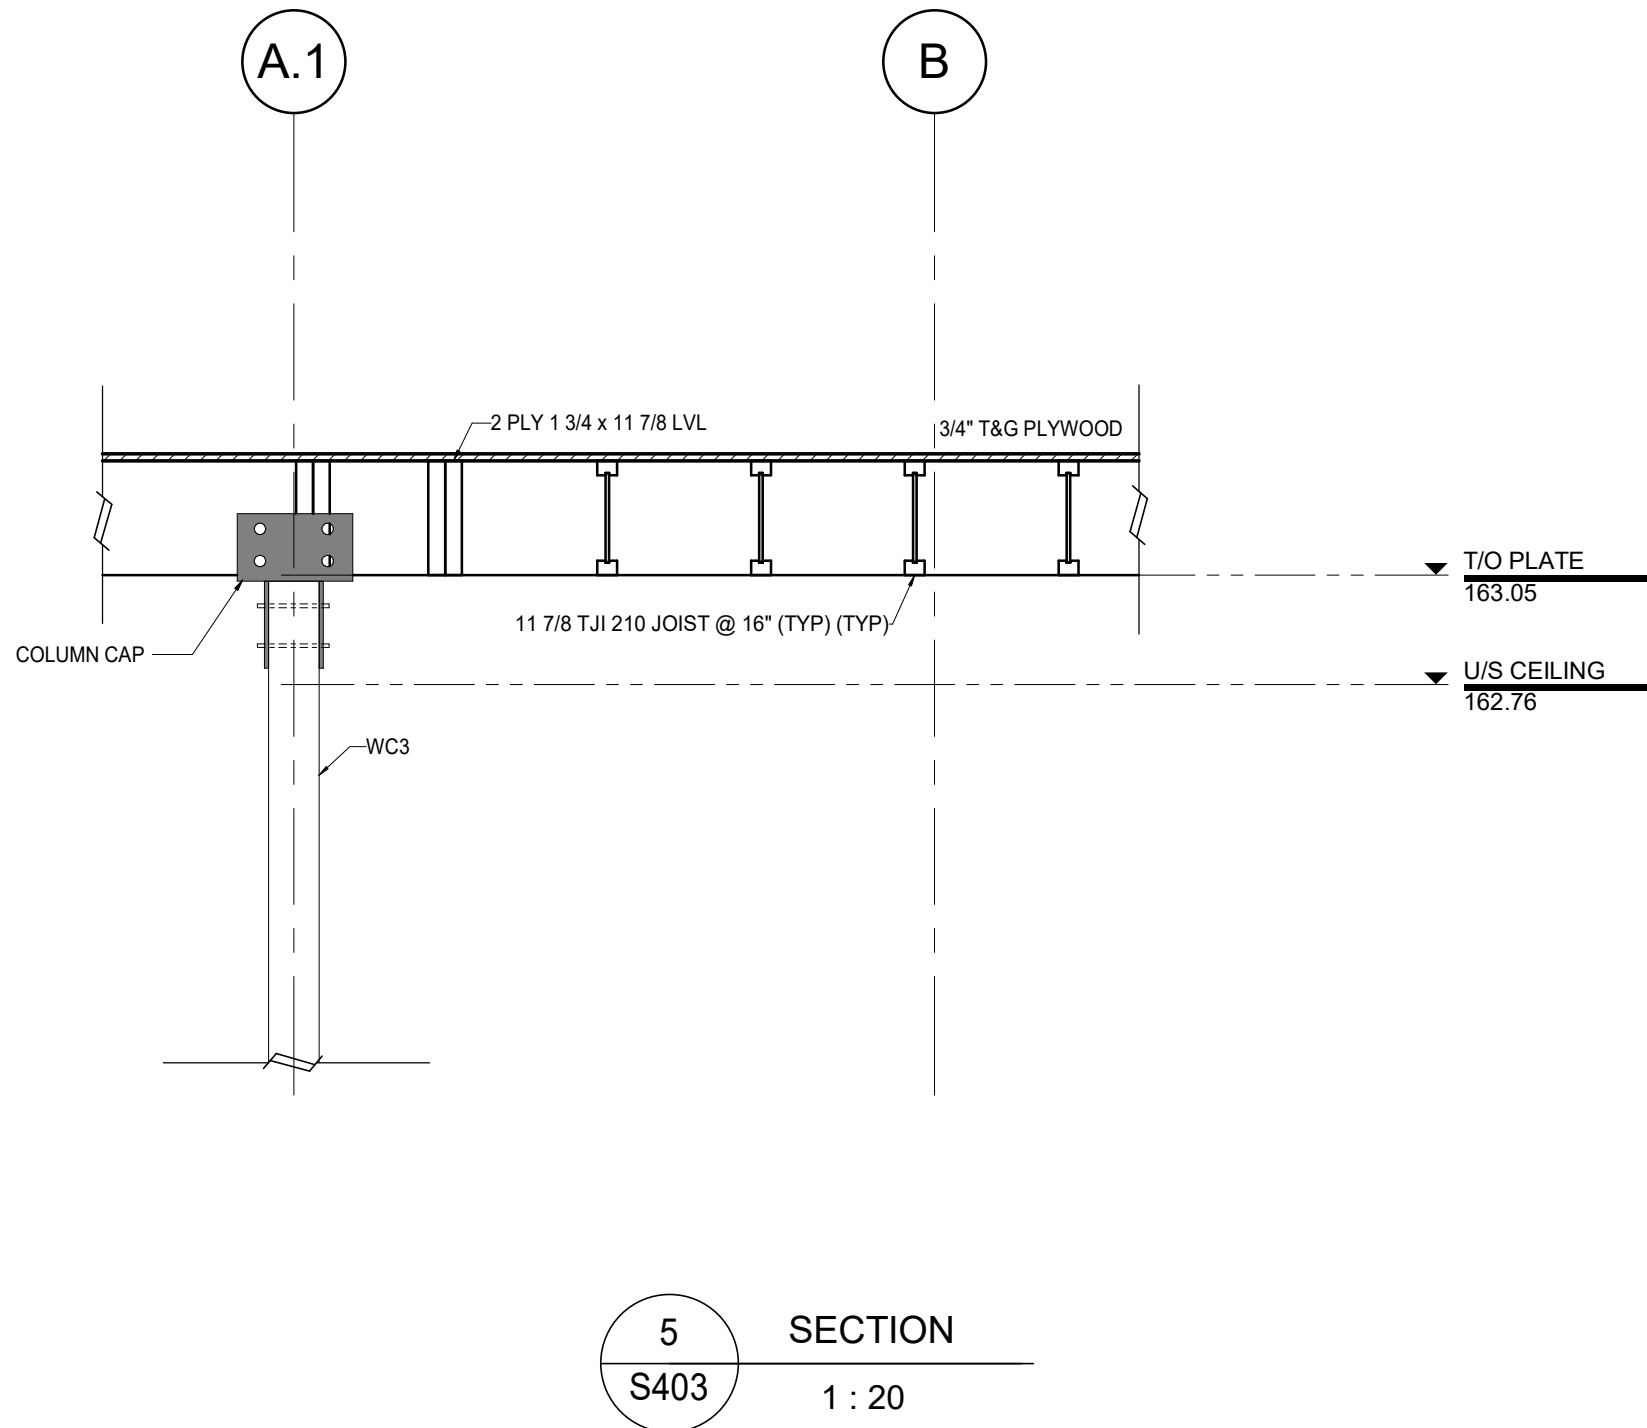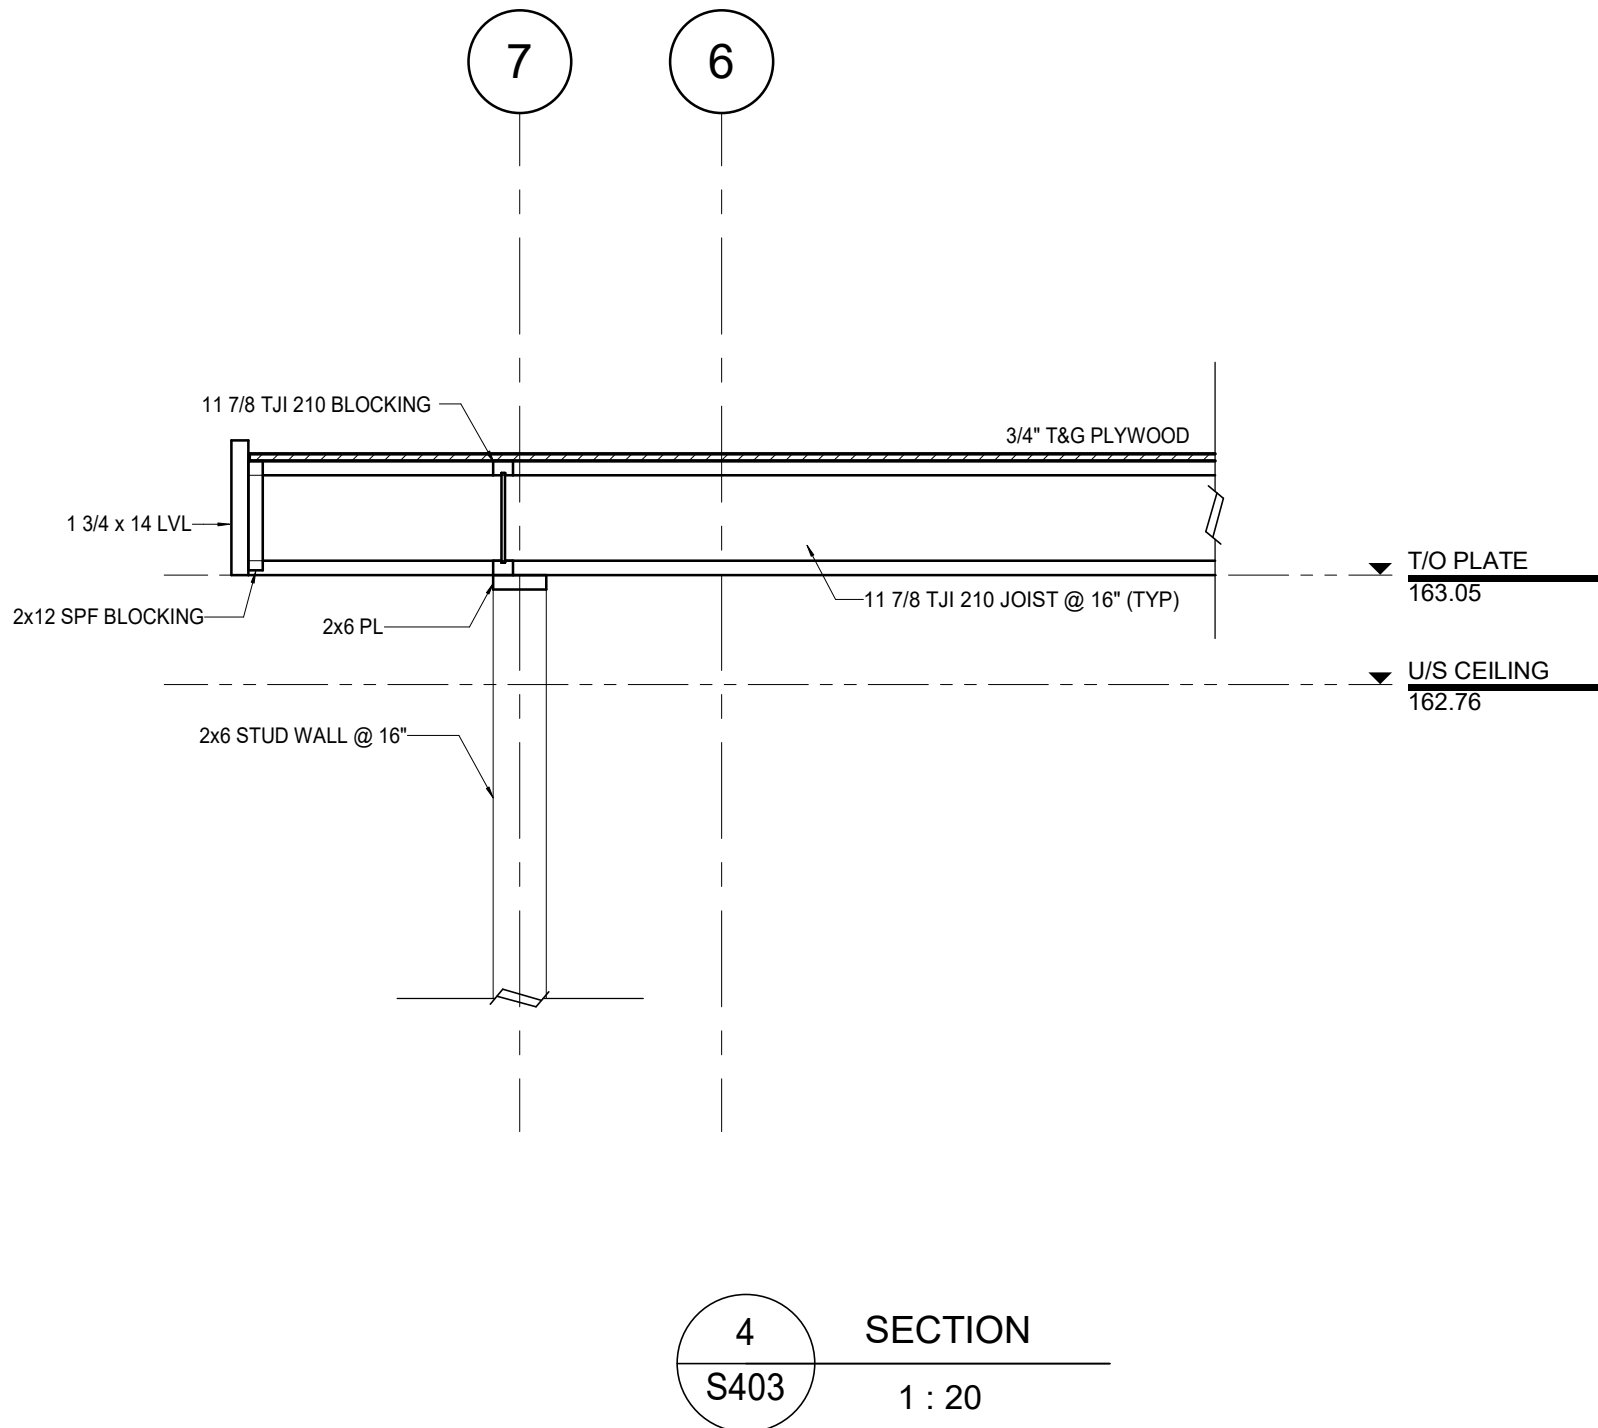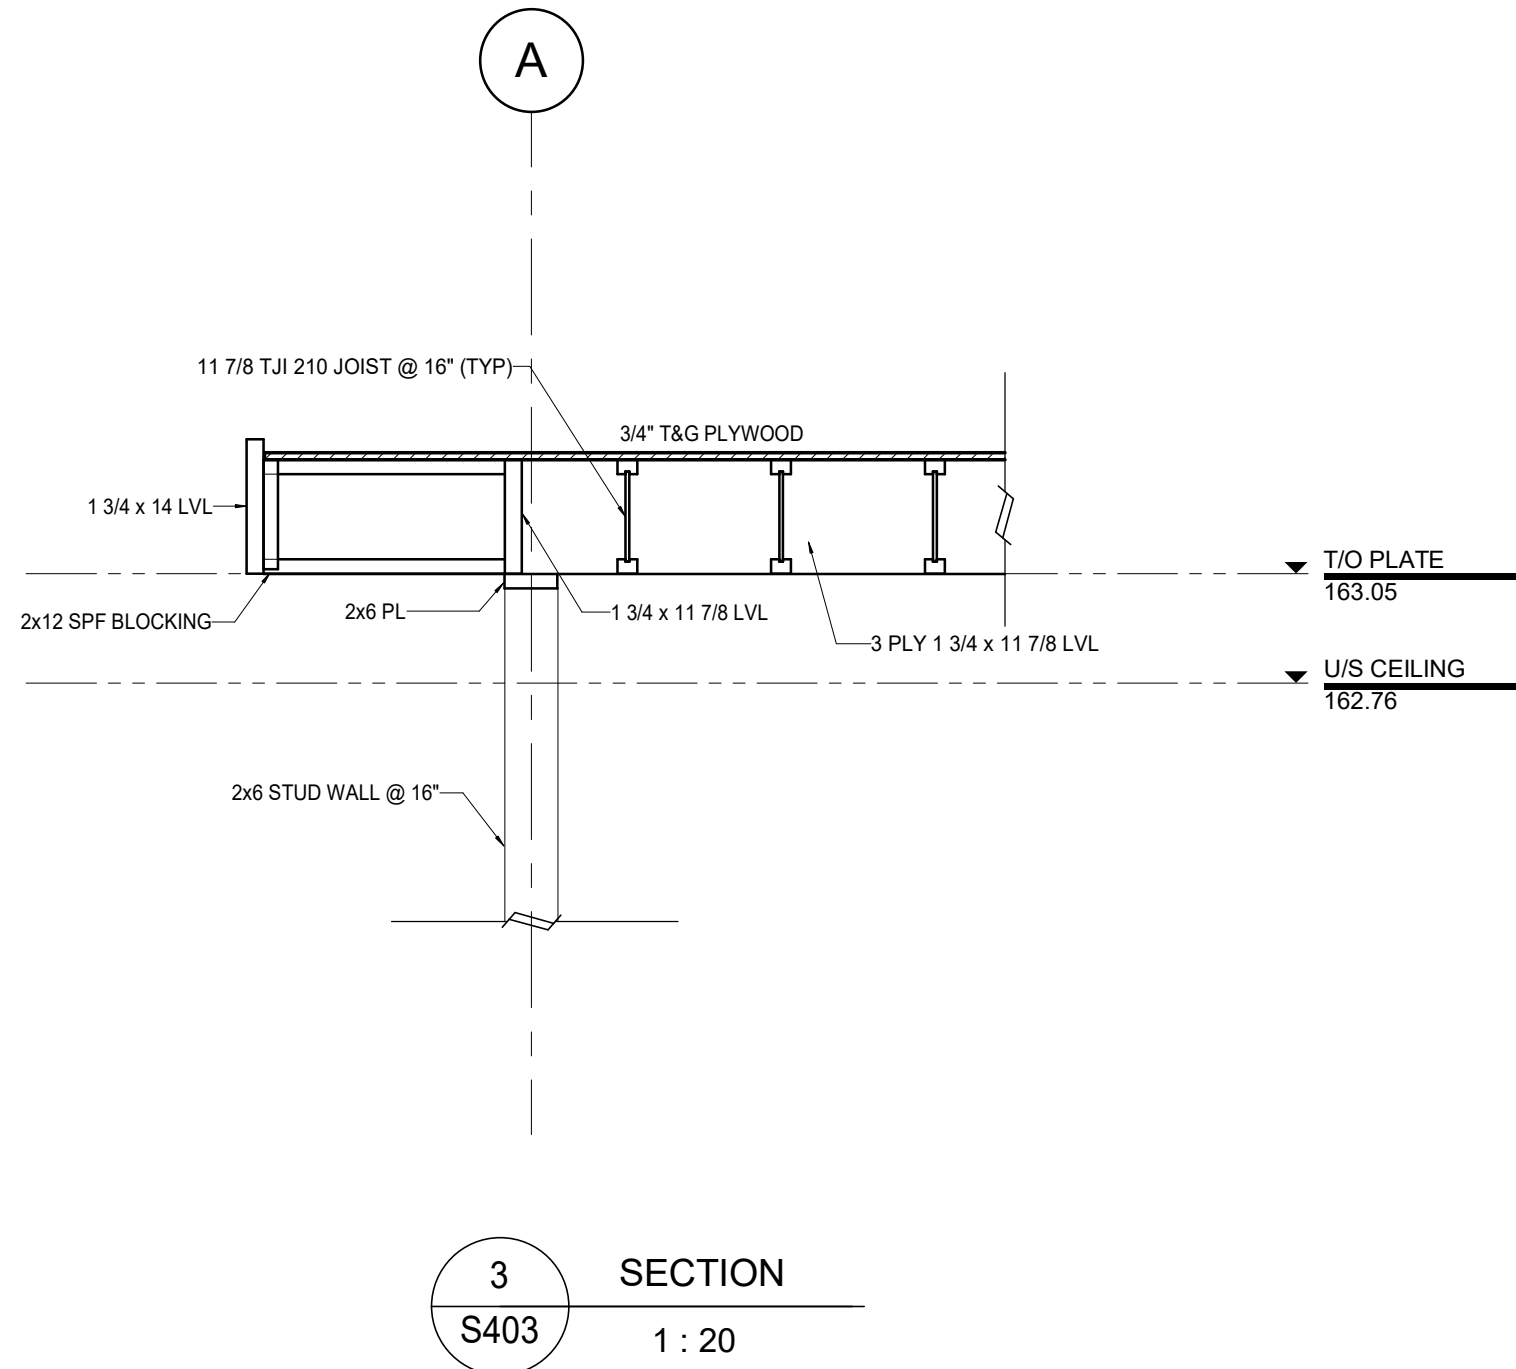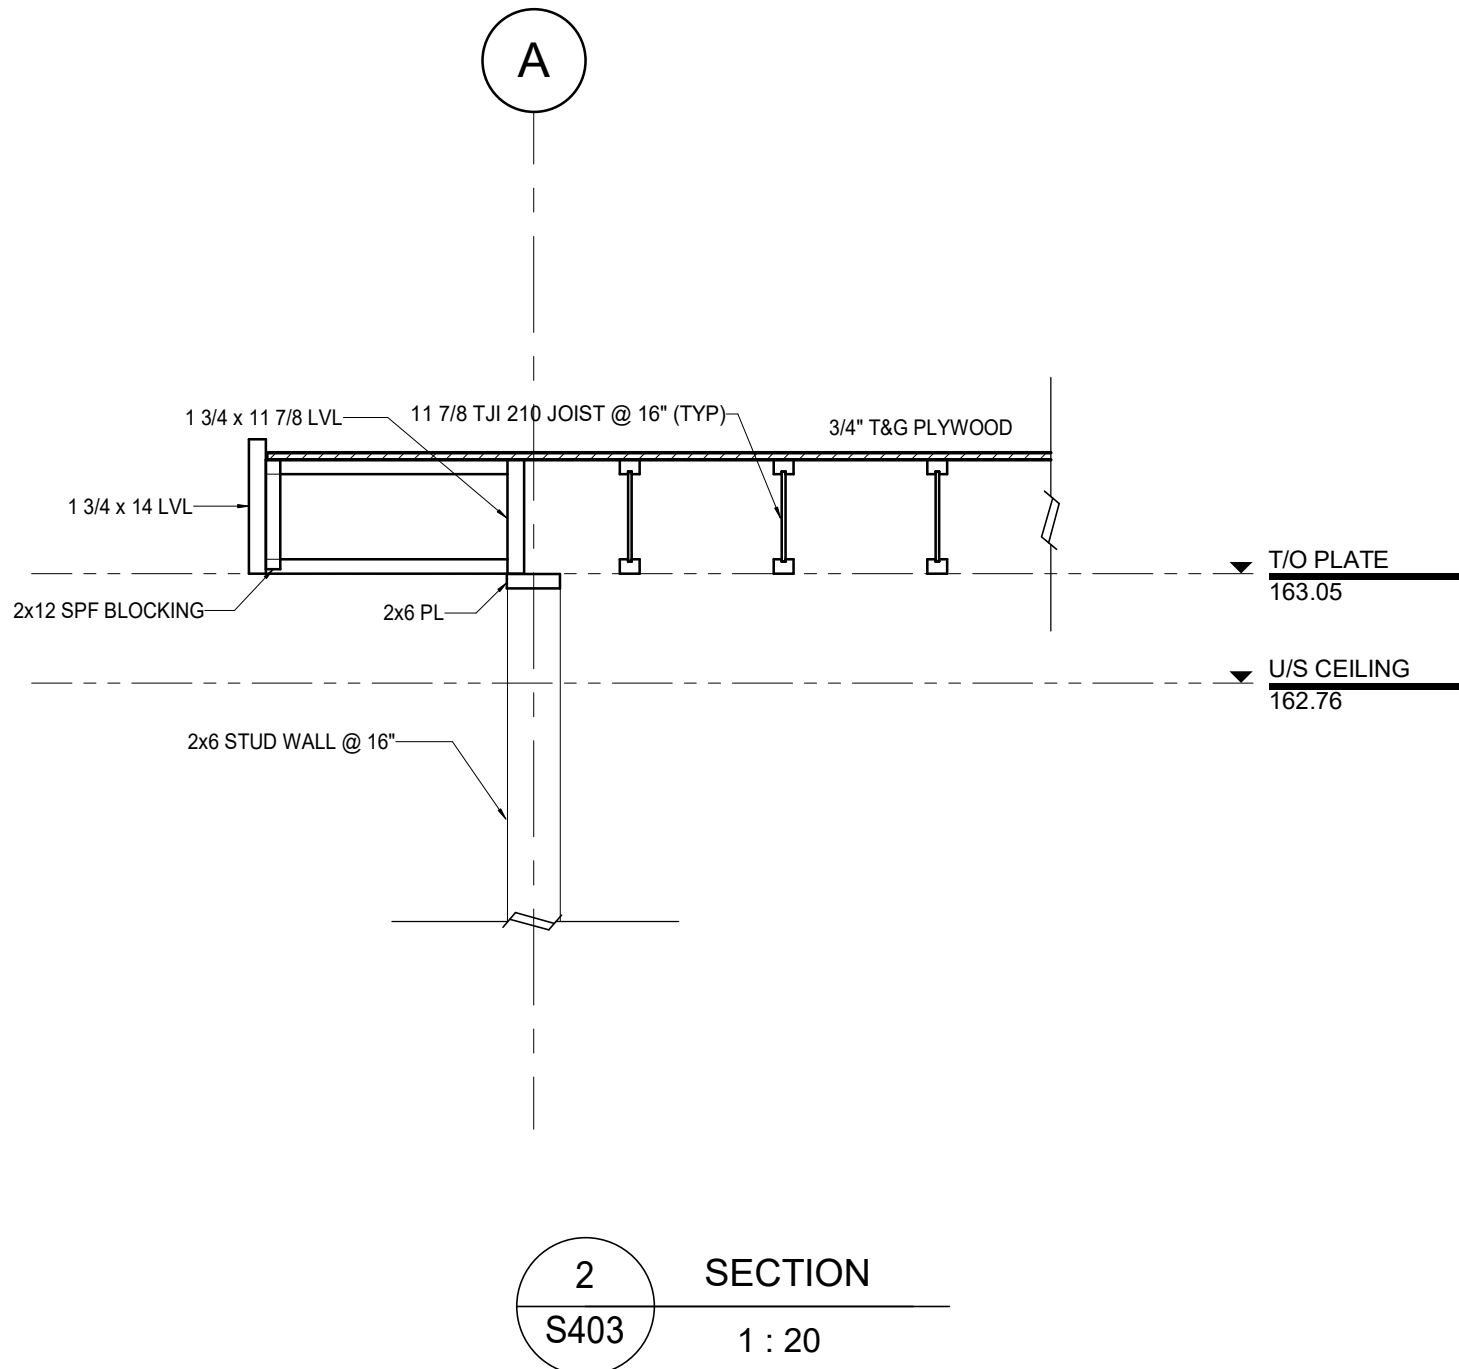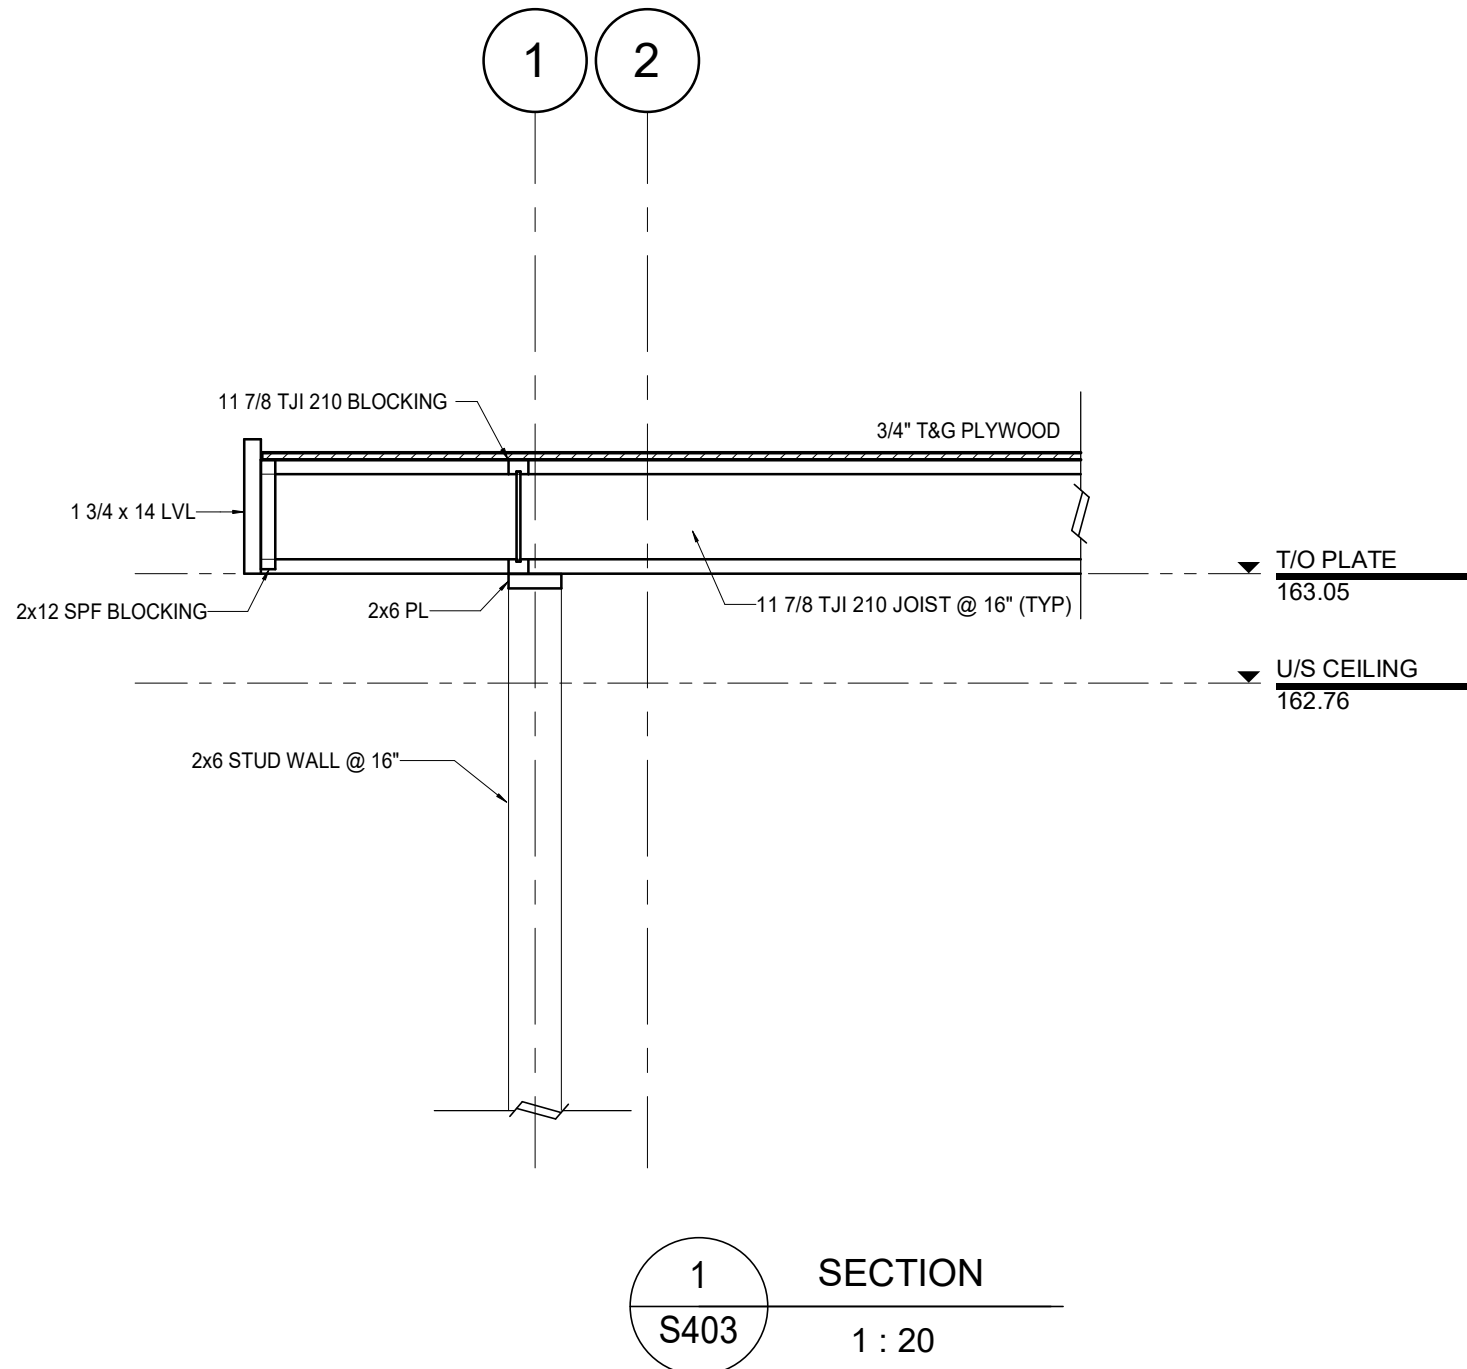

1 2024-09-25 ISSUED FOR PERMIT
2 2024-10-28 ISSUED FOR CONSTRUCTION



4687 Queen Street Suite 2,
Niagara Falls, ON, L2E 2L9
T | 905-357-4441
F | 905-357-9203
W | www.raidmondarchitects.com
E | mail@raidmondarchitects.com

CLIENT NAME

Niagara Adventure Excursion Inc.

PROJECT NAME

Grand View Marketplace
Starbucks

PROJECT ADDRESS

5920 Niagara River Pkwy, Niagara Falls, ON

SHEET NAME

SECTIONS

DRAWN BY:	JC
DATE:	2025-01-23 10:50:47 AM
SCALE:	1 : 20
PROJECT NO.:	24-094
CHECKED:	RY

DRAWINGS ARE NOT VALID FOR CONSTRUCTION UNTIL SEALED AND SIGNED BY THE ARCHITECT.

DO NOT SCALE DRAWINGS. REPORT ALL DISCREPANCIES TO THE ARCHITECT BEFORE PROCEEDING. ALL DRAWINGS AND DESIGNS REMAIN THE PROPERTY OF THE ARCHITECT, AND ARE PROTECTED UNDER COPYRIGHT.

THESE DESIGN DOCUMENTS ARE PREPARED SOLELY FOR THE USE BY THE PARTY WITH WHOM THE DESIGN PROFESSIONAL HAS ENTERED INTO A CONTRACT AND THERE ARE NO REPRESENTATIONS OF ANY KIND MADE BY THE DESIGN PROFESSIONAL TO ANY PARTY WITH WHOM THE DESIGN PROFESSIONAL HAS NOT ENTERED INTO A CONTRACT.

SHEET #

S403

REV. #